


# T.6S.R.1W.W.M.

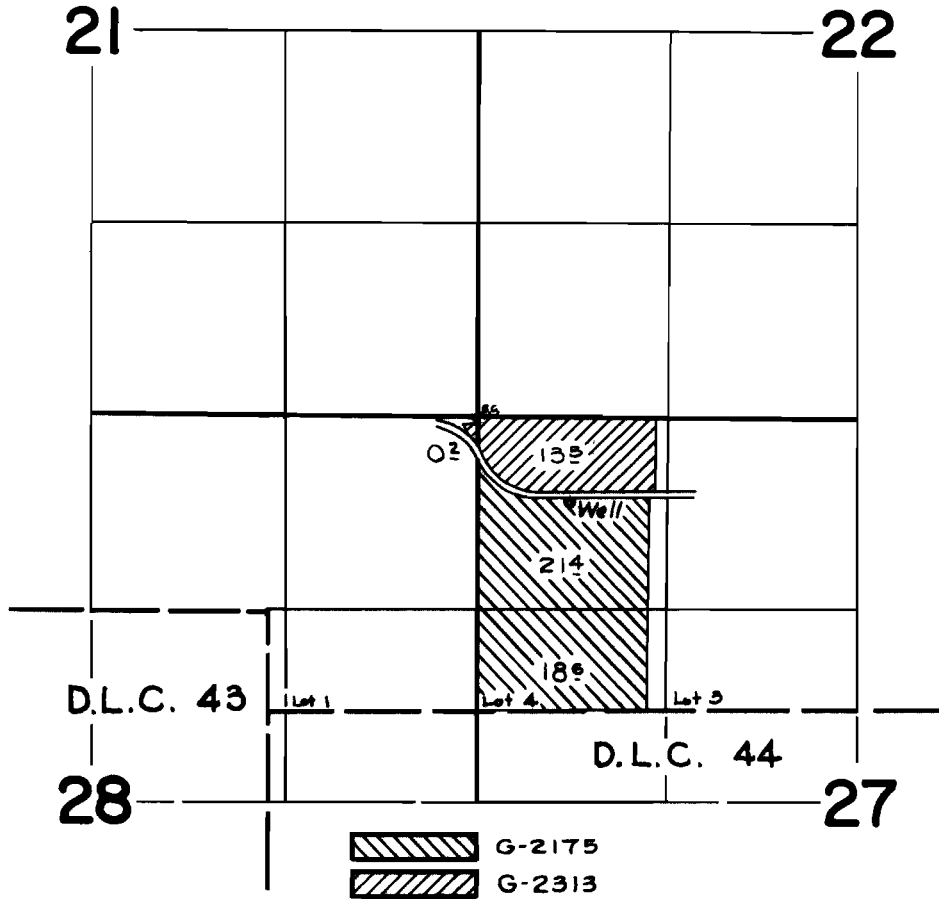

## FINAL PROOF SURVEY UNDER

G-2175                      G-2005  
Application No. ~~G-2313~~ Permit No. ~~G-2139~~  
IN NAME OF

ROBERT ROTH

Surveyed Oct. 25, 1963, by T. LAUER