


T.5S.R.2W.W.M.

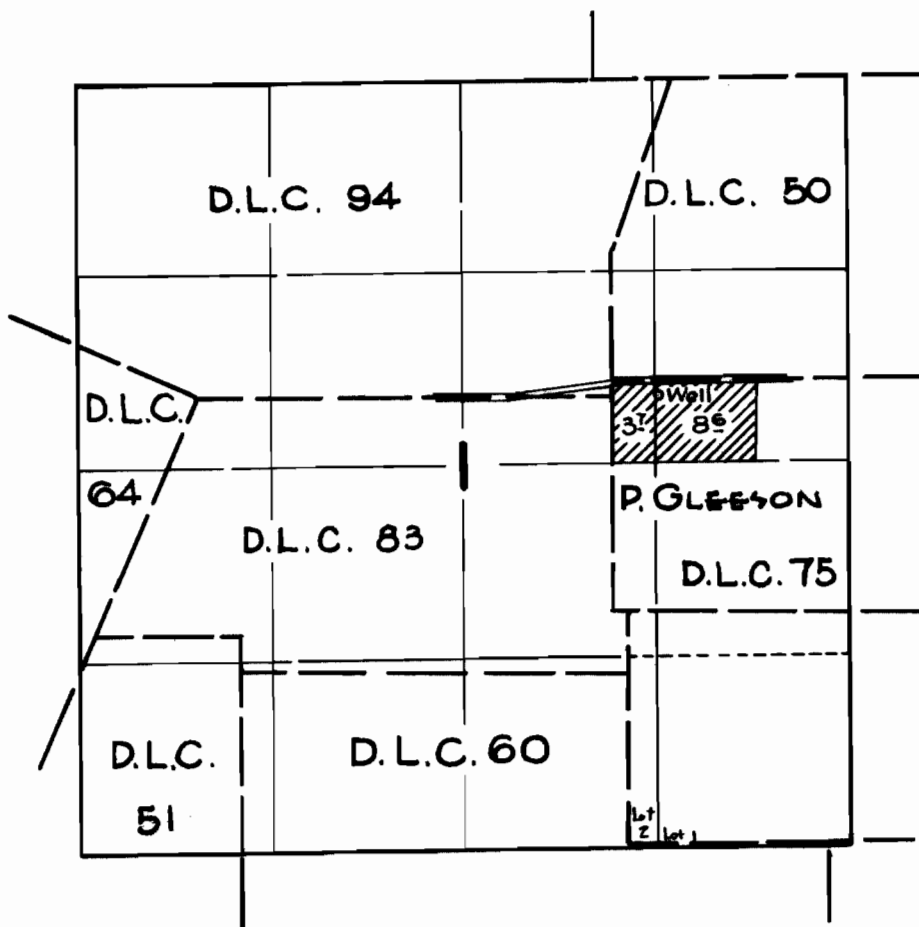

FINAL PROOF SURVEY UNDER

Application No. G-2217 Permit No. G-2041
IN NAME OF

W. J. NAZAROFF

Surveyed April 17 1963, by T. LAUER

2