


T.6S.R.1W.W.M.

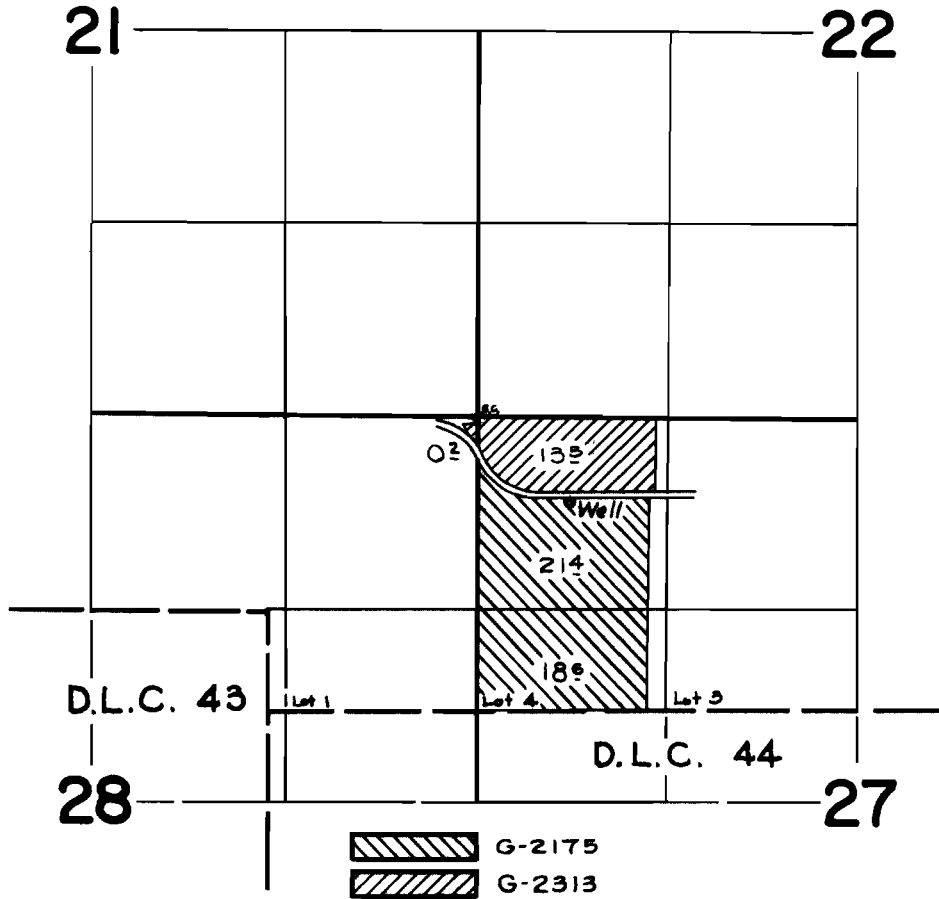

FINAL PROOF SURVEY UNDER

Application No. ~~G-2313~~ ^{G-2175} Permit No. ~~G-2139~~ ^{G-2005}
IN NAME OF

ROBERT ROTH

Surveyed Oct. 25, 1963, by T. LAUER