


T.6S.R.3W.W.M.

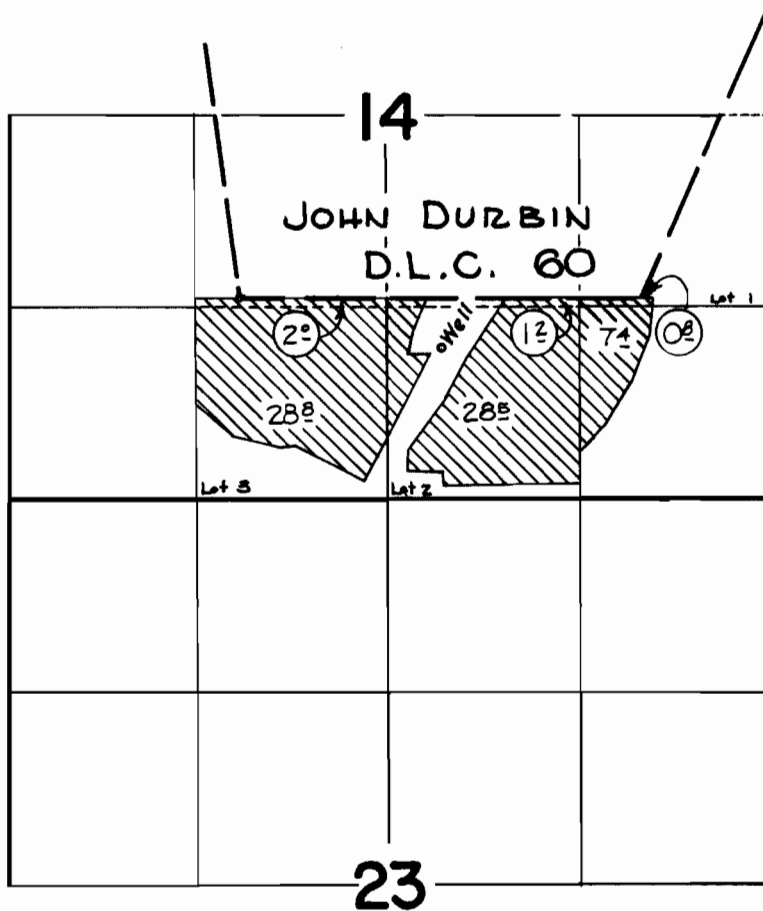

FINAL PROOF SURVEY
UNDER

Application No. G-2367 Permit No. G-2254
IN NAME OF

.....HOMER L. GOULET.....

Surveyed April 25 1963, by T. LAUER.....

Handwritten mark