


T.4S.R.1W.W.M.

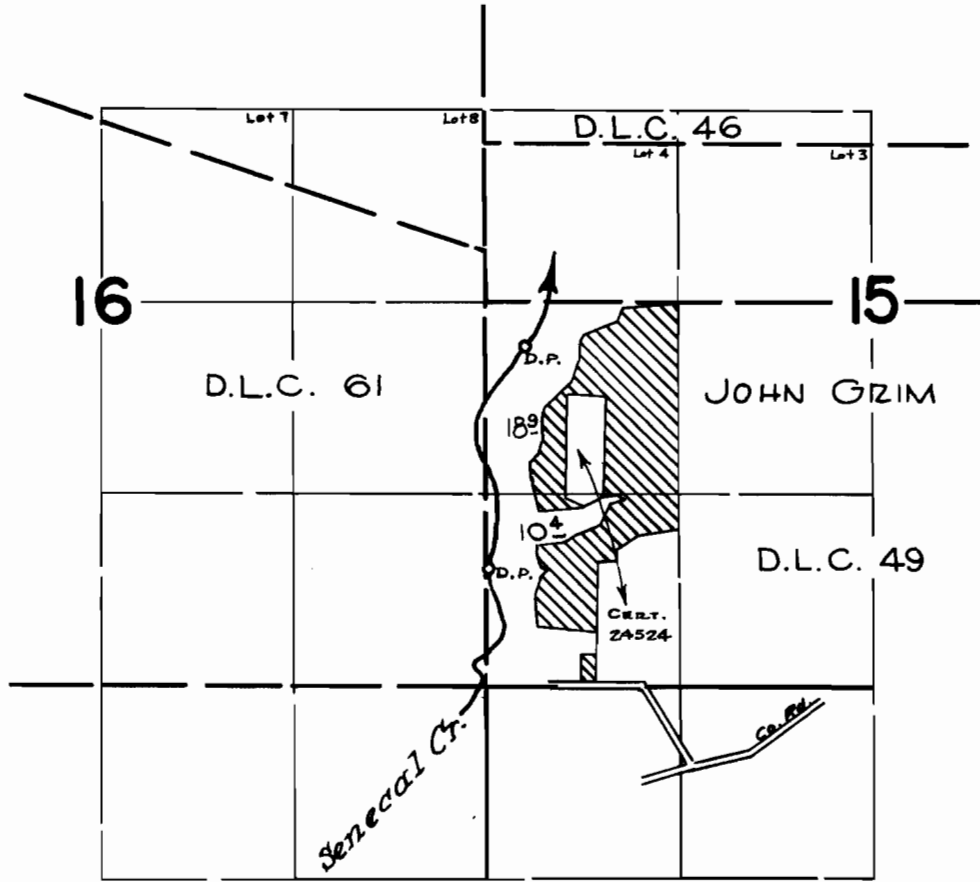

FINAL PROOF SURVEY
UNDER

Application No. 32714... Permit No. 25813...
IN NAME OF

EVERT FREDERICKS

Surveyed April 22 1903, by T. LAUER