


T.6S.R.1E.W.M.

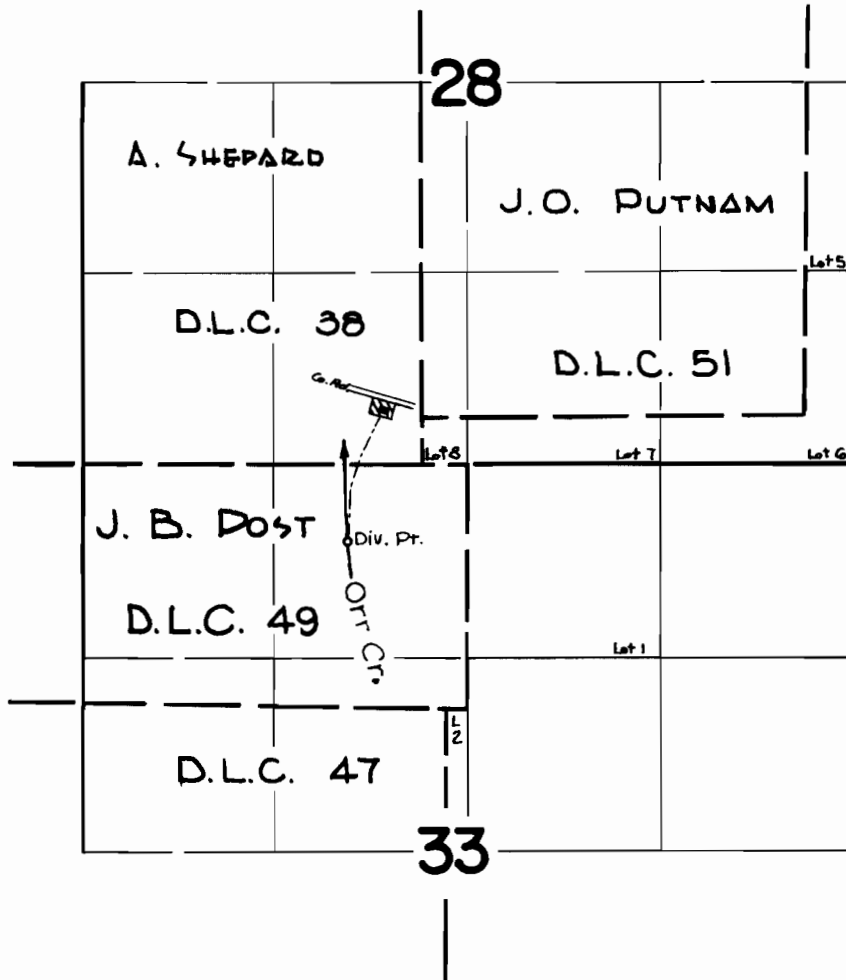

FINAL PROOF SURVEY UNDER

Application No. 34732 Permit No. 27272
IN NAME OF

VERNE V. & THELMA L. CLEMENT

Surveyed July 2, 1963, by T. LAUER