


6-1775  
31849

# T.6N. R.34E. W.M.

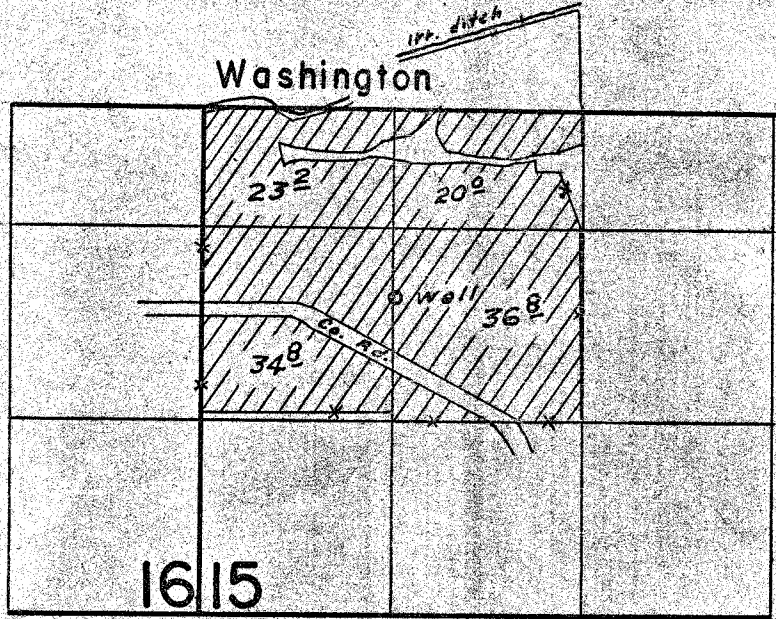

## FINAL PROOF SURVEY UNDER

Application No. G-1929 Permit No. G-1775  
IN NAME OF

U. H. BERNEY ESTATE

Surveyed August 26, 1964, by C. J. Sanderson