


T.6 S.R.39E.W.M.

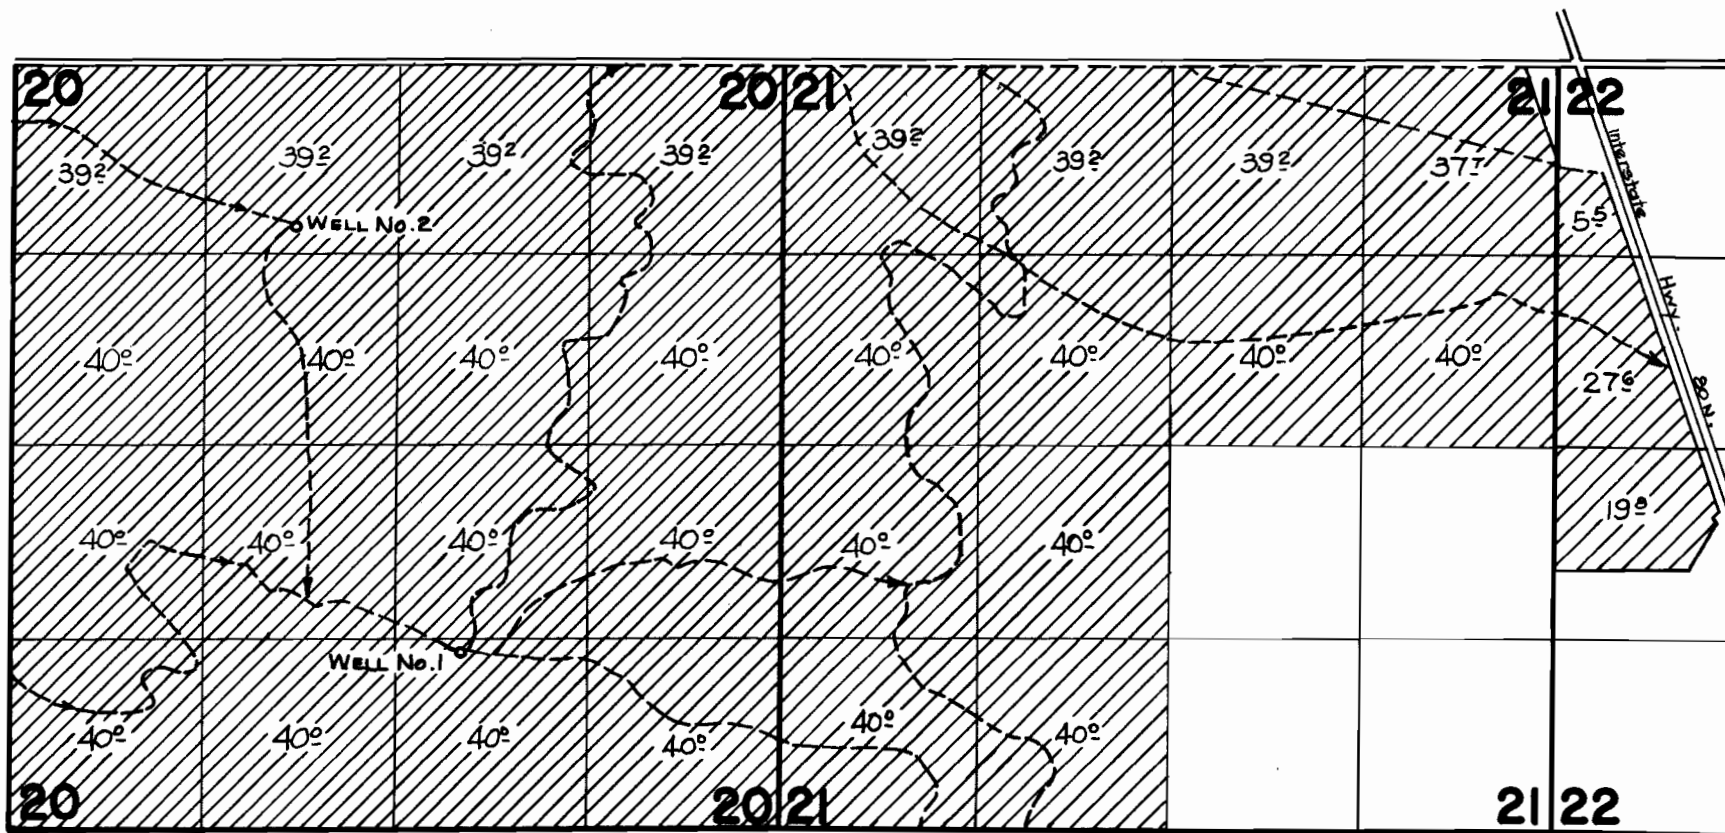

FINAL PROOF SURVEY

UNDER

Application No. G-225 Permit No. G-497

IN NAME OF

MR. & MRS. GLENN PRATT

Surveyed Oct. 1, 1963, by C. R. BAKER