


# T.6S.R.39E.W.M.

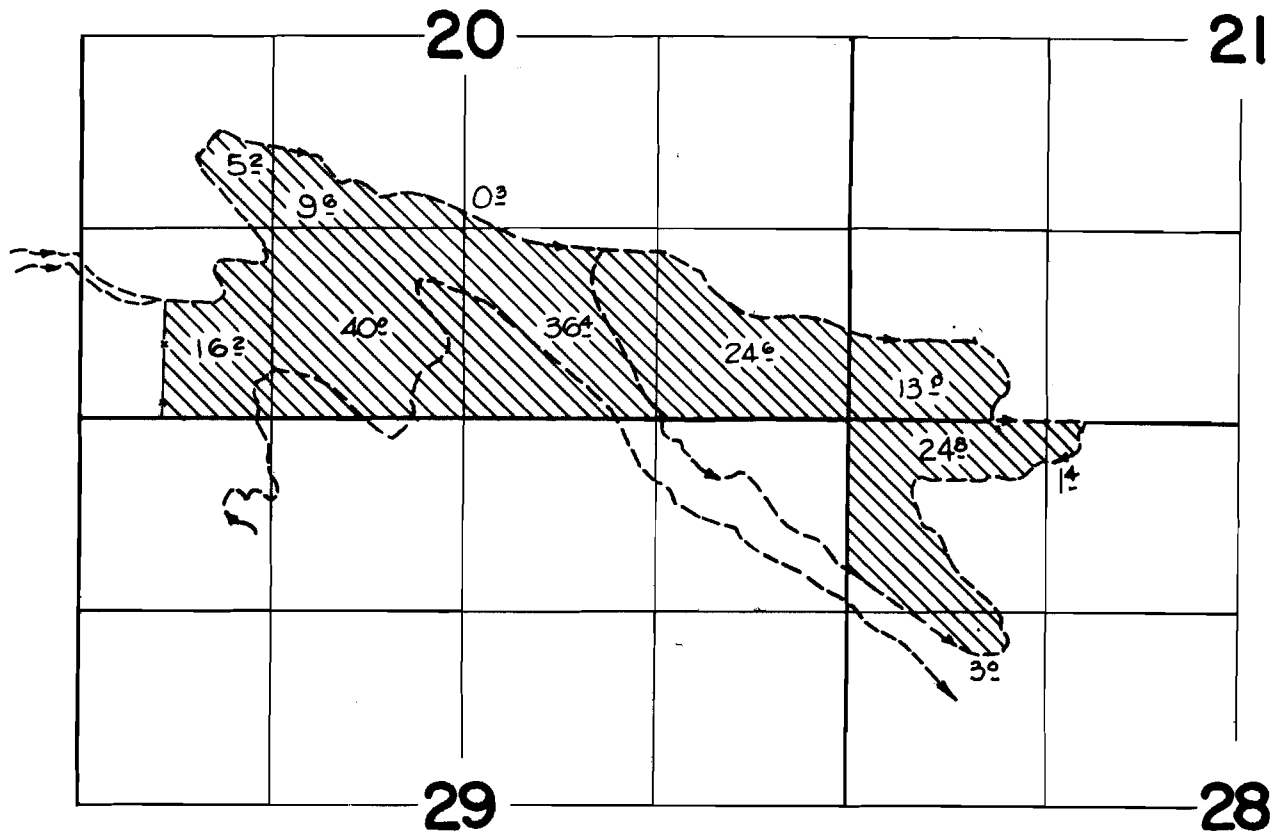

## FINAL PROOF SURVEY UNDER


Application No. 32263... Permit No. 25449...  
IN NAME OF

MR. & MRS. GLENN PRATT

Surveyed Oct. 1, 1963, by C. D. BAKER

St

T. 6 S., R. 38 E.

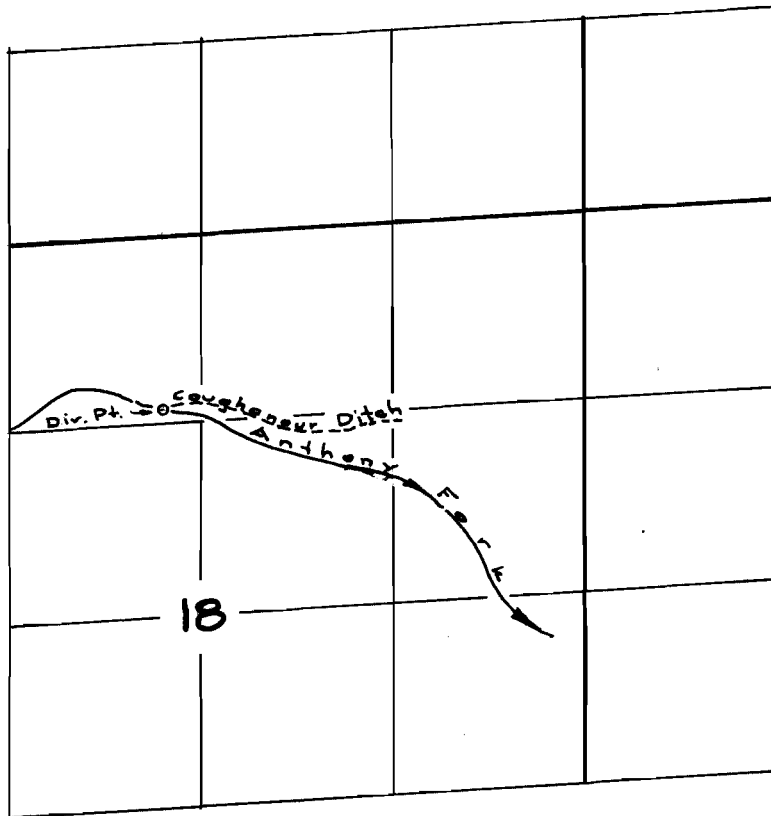

**FINAL PROOF SURVEY**  
UNDER

Application No. 32263 Permit No. 25449  
IN NAME OF

MR. & MRS. GLENN PRATT

Surveyed April 21, 1964 by D. B. Hall