


T.2S.R.13E.W.M.

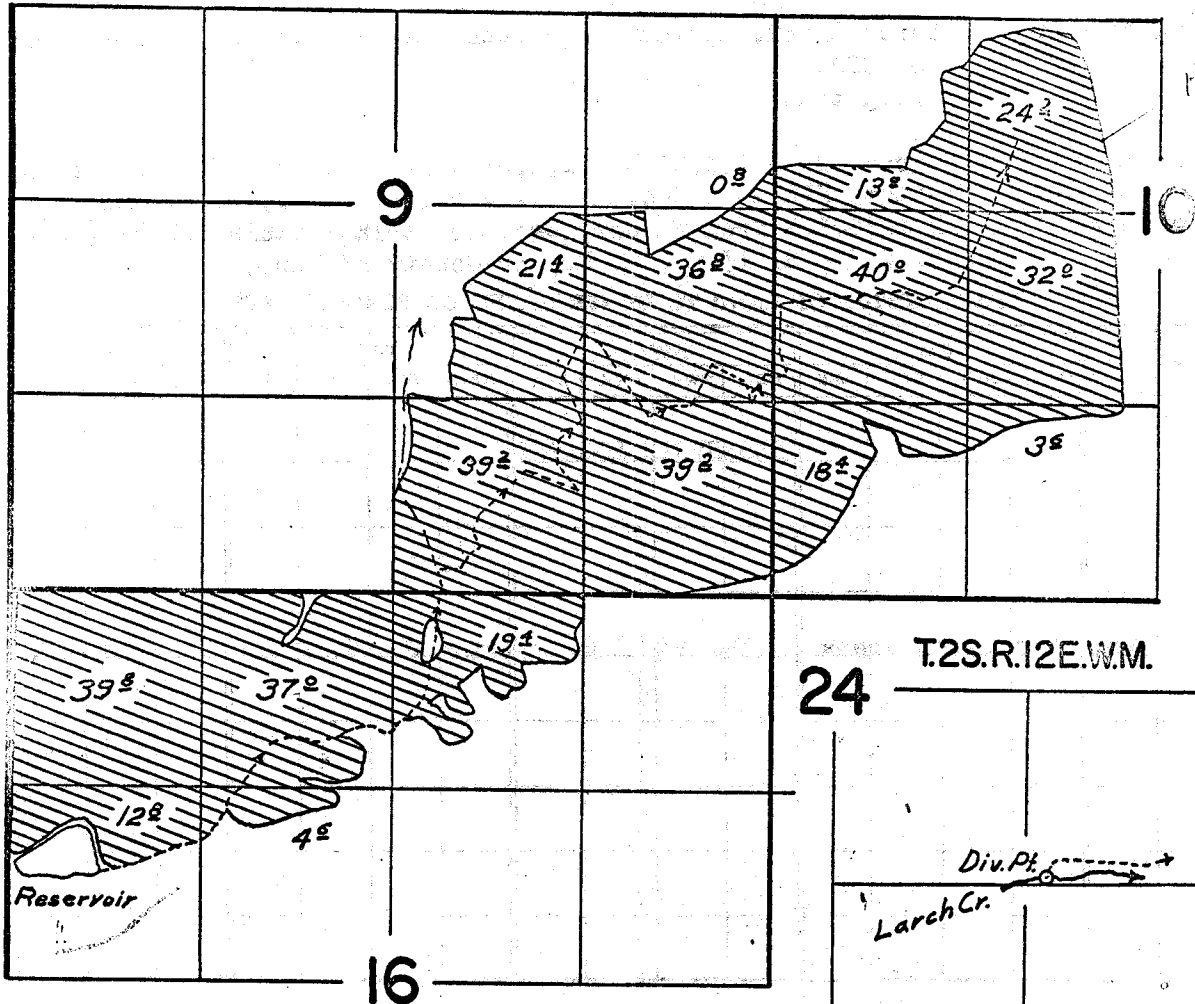

Handwritten notes: HULL, 10 1/2

FINAL PROOF SURVEY UNDER

Application No. R-28747 Permit No. R-1600
28139 22811
IN NAME OF

Eugene Chase

Surveyed April 17 1962, by Thomas R. Lauer