


4  
23559  
(25310)

# T. 2 N. R. 11 E. W. M.

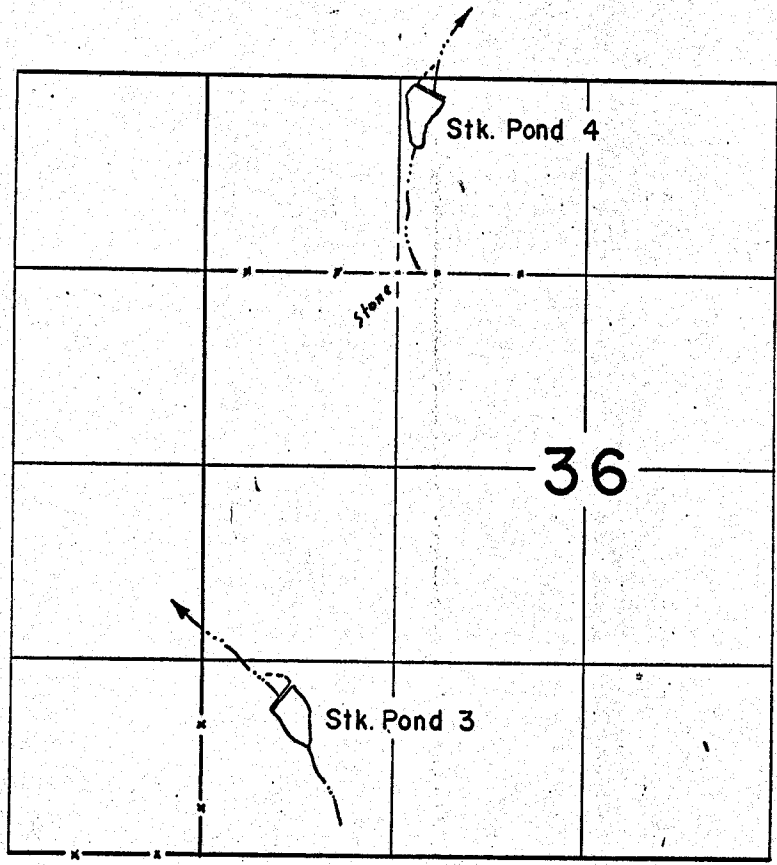

## FINAL PROOF SURVEY

UNDER

R-28770                      R-1728  
30099                         23559  
R-32019                      R-2109

Application No. 32103..... Permit No. 25310.....  
IN NAME OF

GILBERT HOWARD WILEY

Surveyed April 2... 1963, by *Larry J. Howard*