


4
23559
(25310)

T. 2 N. R. 11 E. W. M.

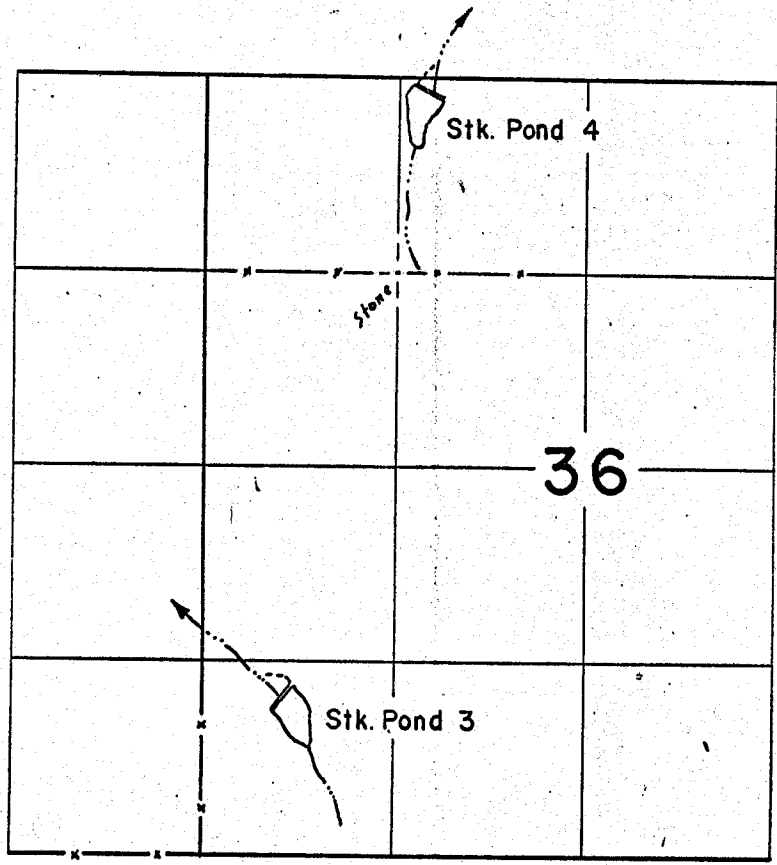

FINAL PROOF SURVEY

UNDER

R-28770 R-1728
30099 23559
R-32019 R-2109

Application No. 32103..... Permit No. 25310.....
IN NAME OF

GILBERT HOWARD WILEY

Surveyed April 2... 1963, by *Larry J. Howell*