


26462

T. 1 S. R. 12 E. W.M.

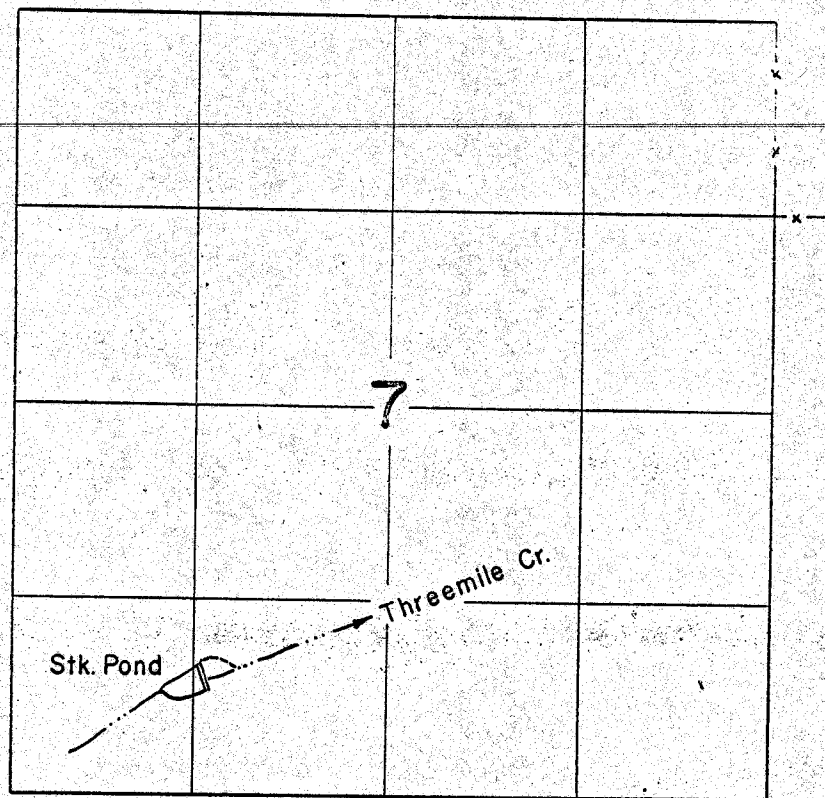

FINAL PROOF SURVEY UNDER

R-33473 R-2304
Application No. 33474.. Permit No. 26462....
IN NAME OF

.....EDWIN E. LIECHTI.....

Surveyed April... 1, 1963, by *Larry Gehouse*