


26462

# T. 1 S. R. 12 E. W.M.

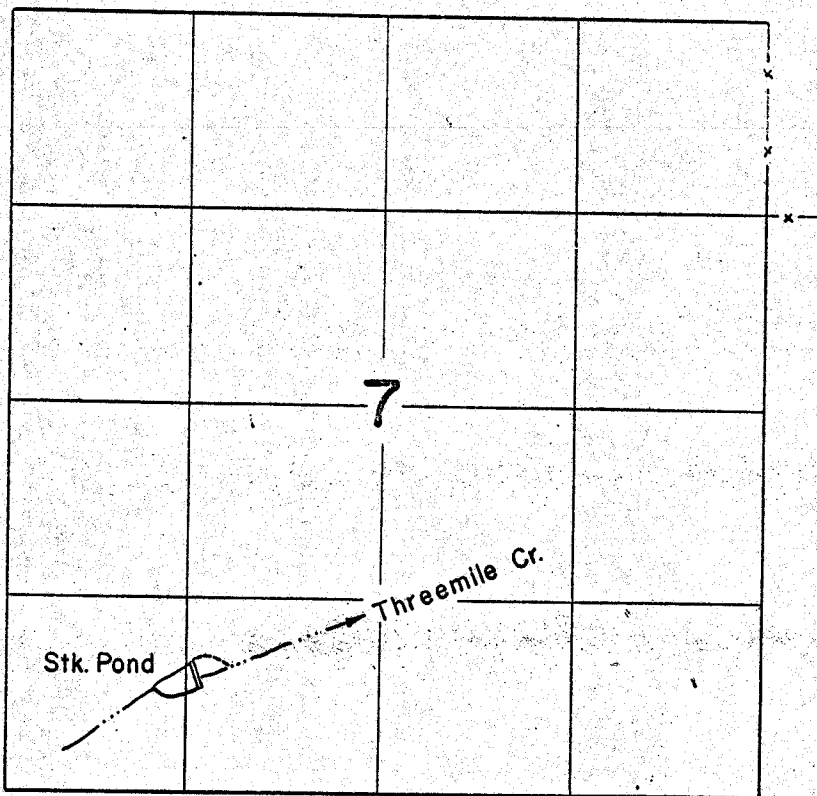

## FINAL PROOF SURVEY UNDER

R-33473                      R-2304  
Application No. 33474    Permit No. 26462....  
IN NAME OF

.....EDWIN E. LIECHTI.....

Surveyed April 1, 1963, by *Lauferhouse*