


27041

T.1 N. R.12 E.W.M.

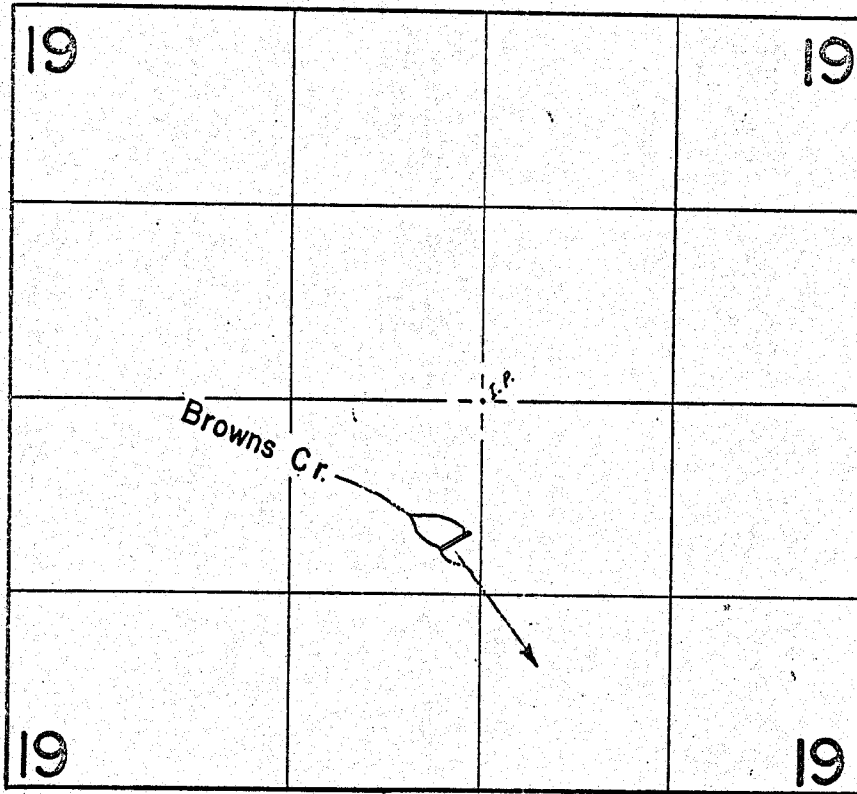

FINAL PROOF SURVEY UNDER

R-34026 R-2519
Application No. 34431 Permit No. 27041
IN NAME OF

WILLIAM D. KETCHUM

Surveyed March 30 1963, by Larry Gelousek