


4
27062

T. 1 N. R. 12 E. W. M.

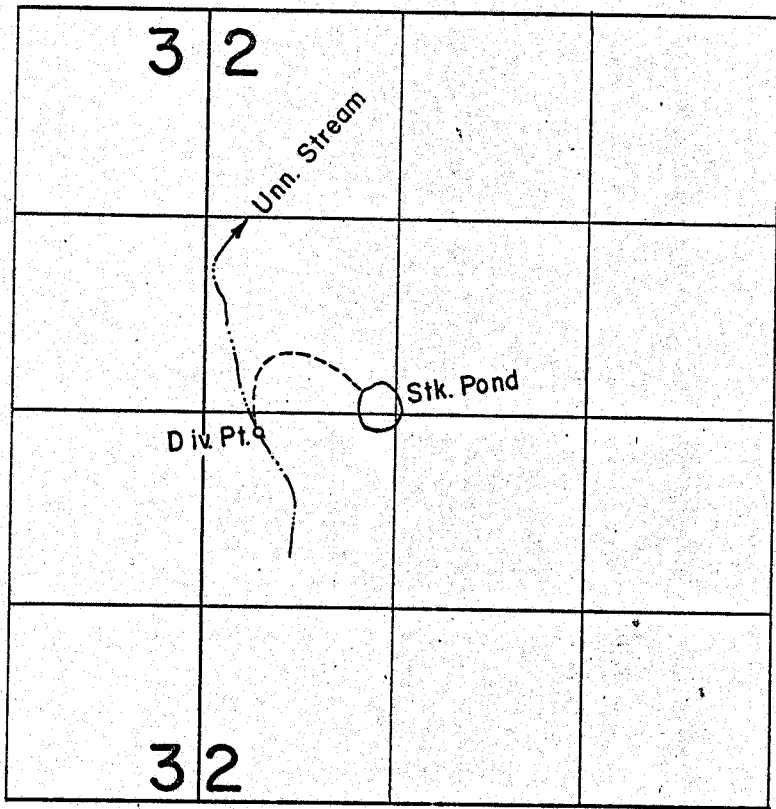

FINAL PROOF SURVEY UNDER

R-34025 R-2557
Application No. 34430... Permit No. 27062....
IN NAME OF

.....WILLIAM D. KETCHUM.....

Surveyed March..30 1963., by *Harry Jelousch*