


T. 1 S. R. 12 E. W.M.

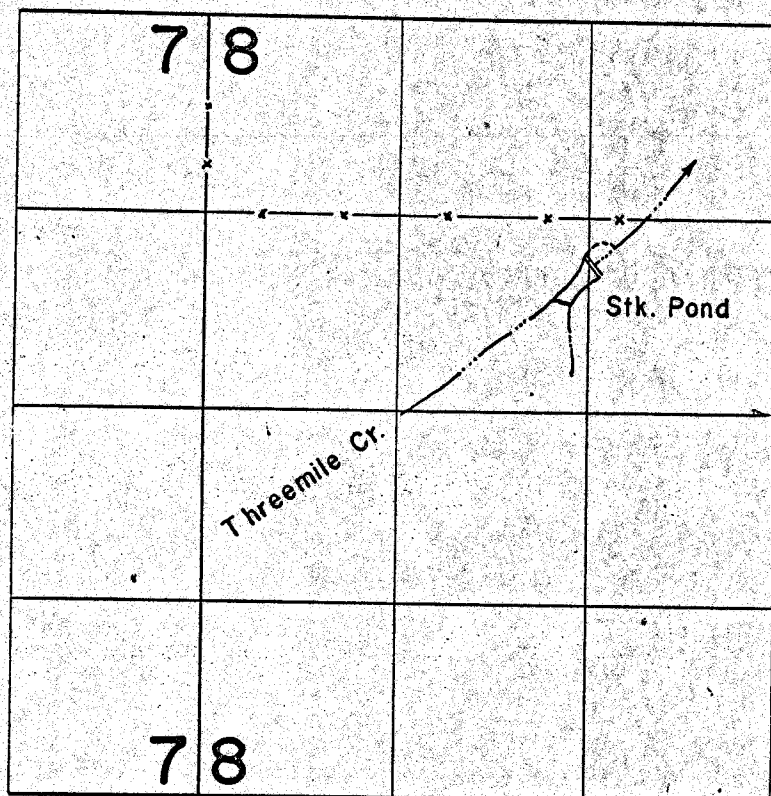

FINAL PROOF SURVEY UNDER

R-34500 R-2572
 Application No. 34501... Permit No. 27103...
 IN NAME OF

.....EDWIN LEICHTI.....

Surveyed April 1... 1963, by *Larry Johnson*