


# T. 1 S. R. 12 E. W.M.

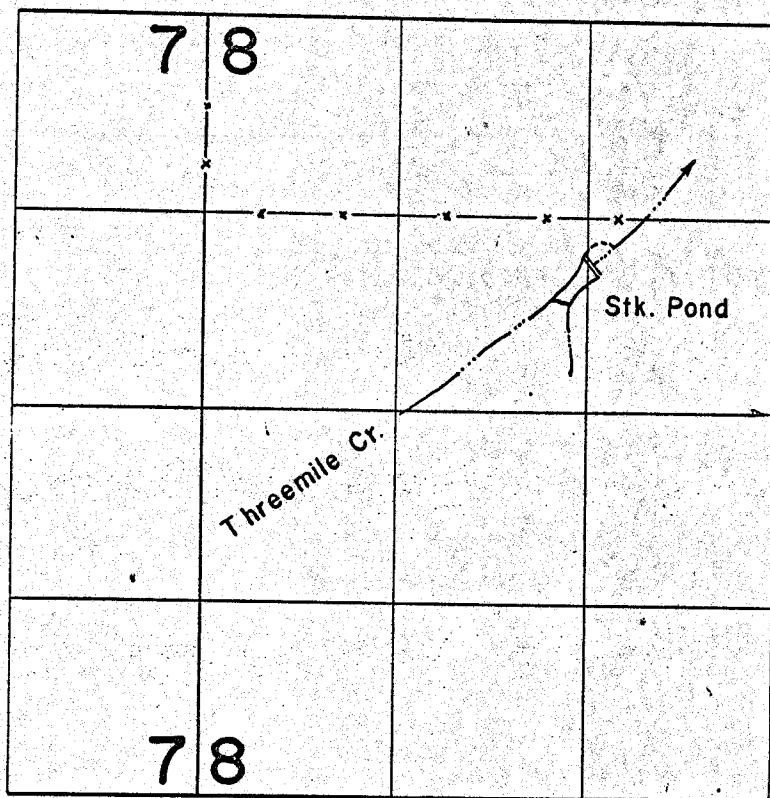

## FINAL PROOF SURVEY UNDER

R-34500                      R- 2572  
 Application No. 34501... Permit No. 27103...  
 IN NAME OF

.....EDWIN LEICHTI.....

Surveyed April 1... 1963, by *Larry Johnson*