


T.3N. R.3W.W.M.

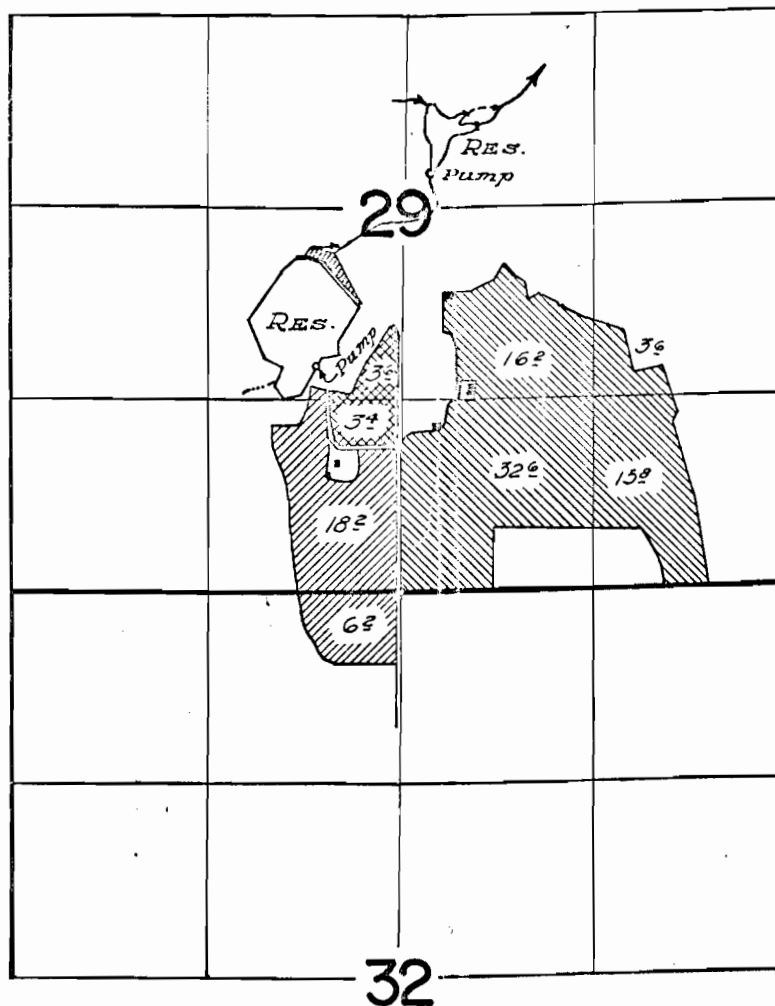

North Reservoir

South Reservoir

FINAL PROOF SURVEY
UNDER

24066
R-26428
R-28877

20472
R-1252
R-1660

Application No. 29323... Permit No. 23125...
IN NAME OF

D.D. & KATHERINE BUMP

Surveyed Sept. 9, 1960, by

Apperson