


T.3N. R.3W.W.M.

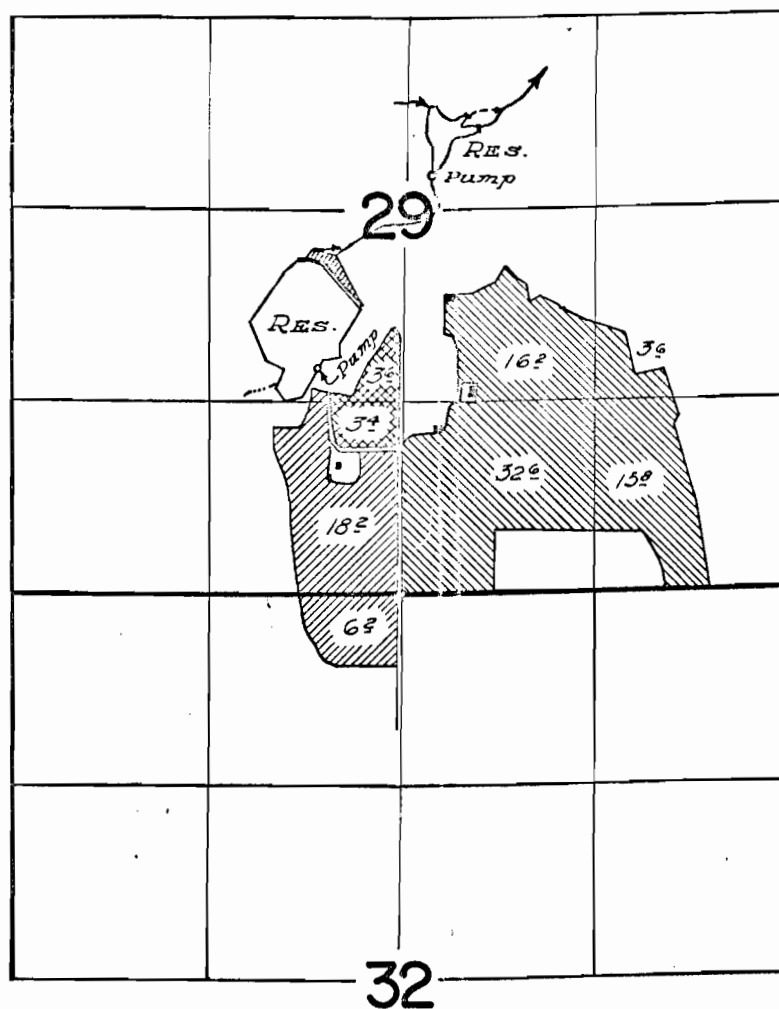

 North Reservoir
 South Reservoir

FINAL PROOF SURVEY
UNDER

24066 20472
R-26428 R-1252
R-28877 R-1660
Application No. 29323 Permit No. 23125
IN NAME OF

D.D. & KATHERINE BUMP

Surveyed Sept. 9, 1960, by *Johnson*