


T.3N.R.5W.W.M.

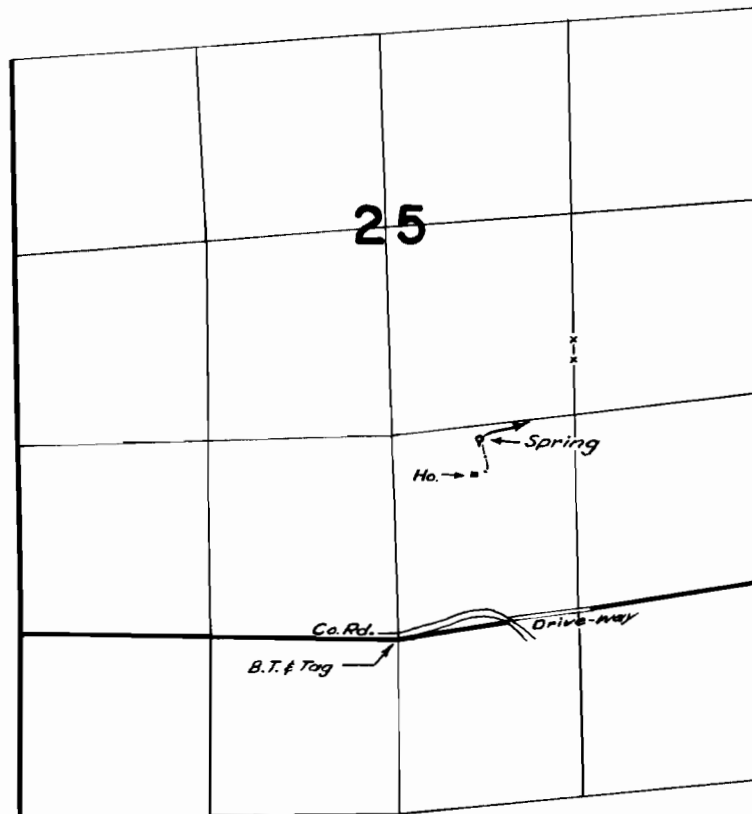

FINAL PROOF SURVEY
UNDER

Application No. 34128 Permit No. 26896
IN NAME OF

AUGUSTINE STRASEL

Surveyed June 26 1962, by M. Bish