


T. 3 N. R. 3 W. W.M.

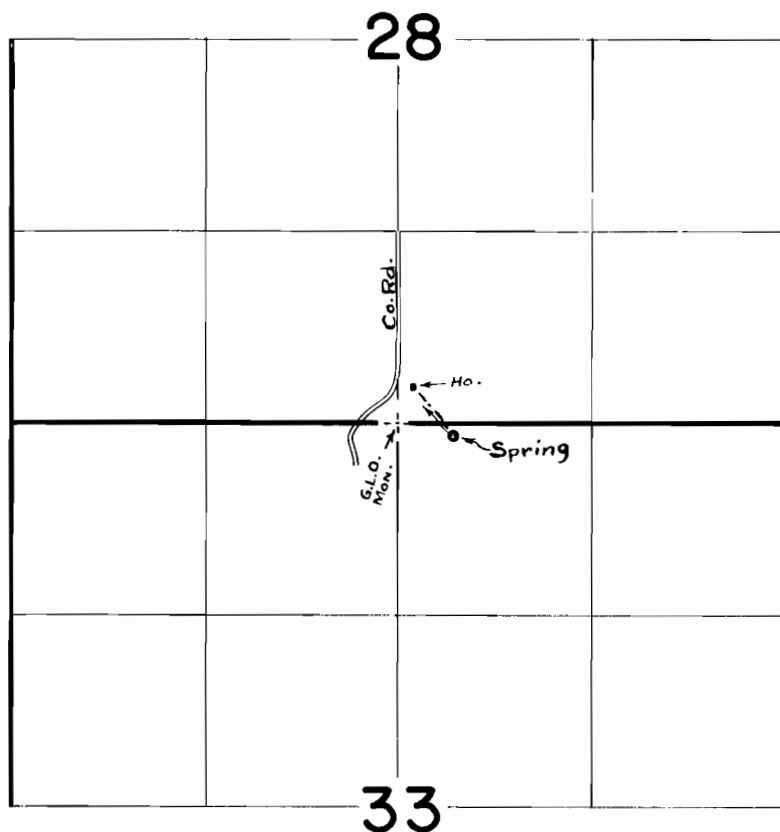

FINAL PROOF SURVEY
UNDER

Application No. 37622 Permit No. 28056
IN NAME OF

WILLIAM H. NEAGLE

Surveyed MAR. 26 1963, by M. Bish