


T. 4 S. R. 4 W. W. M.

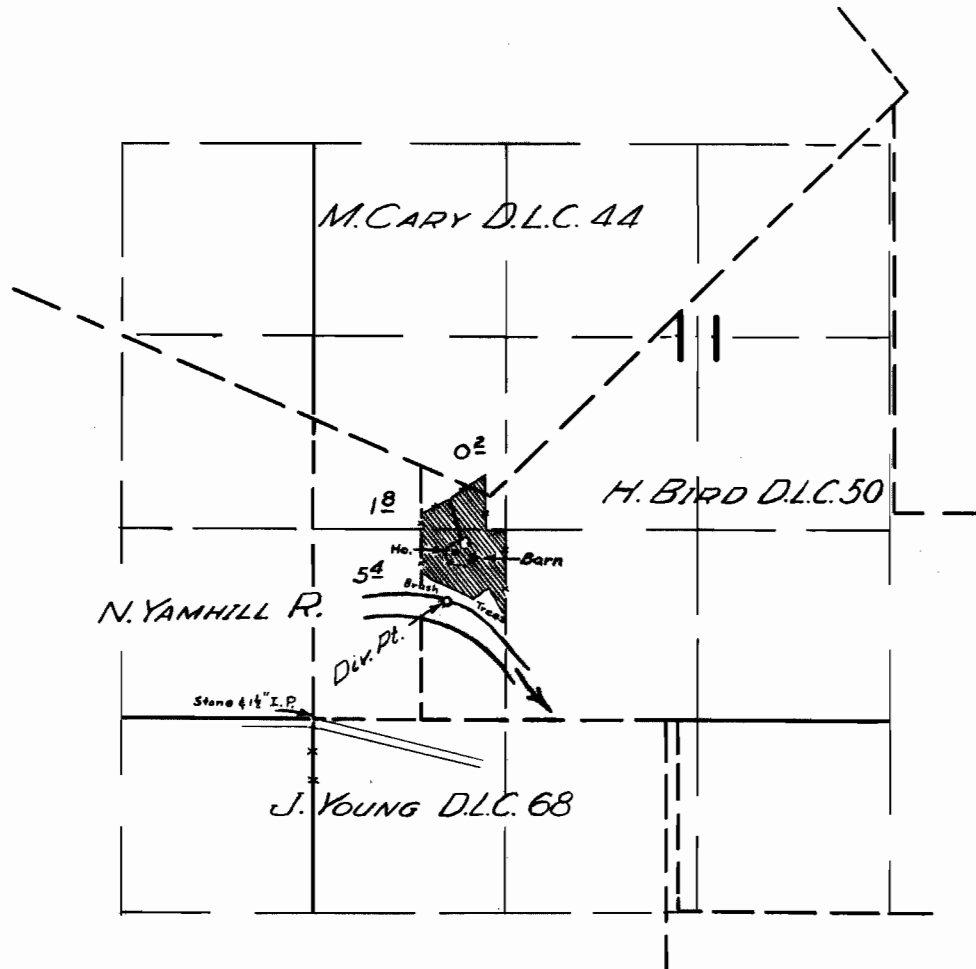

FINAL PROOF SURVEY
UNDER

Application No. 32929 Permit No. 26024
IN NAME OF

RALPH E. BUNN

Surveyed MAY 16 1963, by m. Bish