


T. 3 S. R. 3 W.W.M.

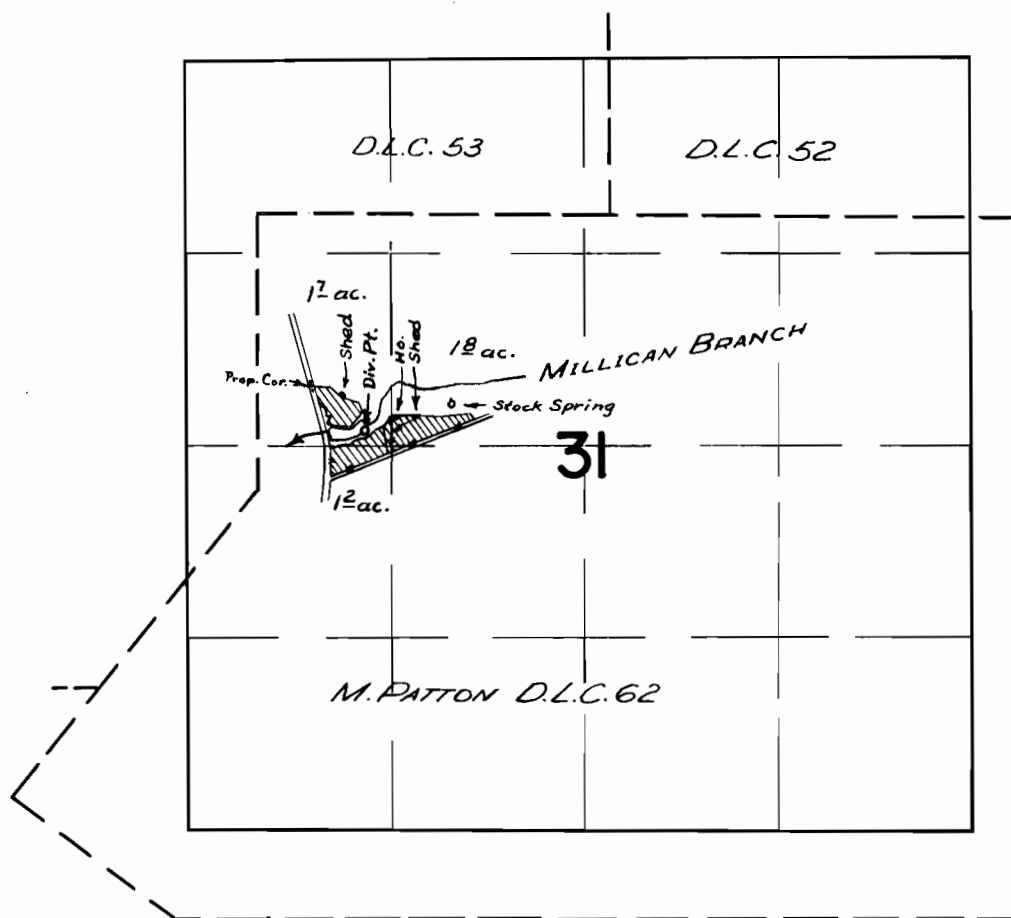

FINAL PROOF SURVEY
UNDER

Application No. 37013 Permit No. 27560
IN NAME OF

VERGIL & MILDRED LOUDON

Surveyed April 11, 1963, by M. Bish