


T. 3 S. R. 3 W. W.M.

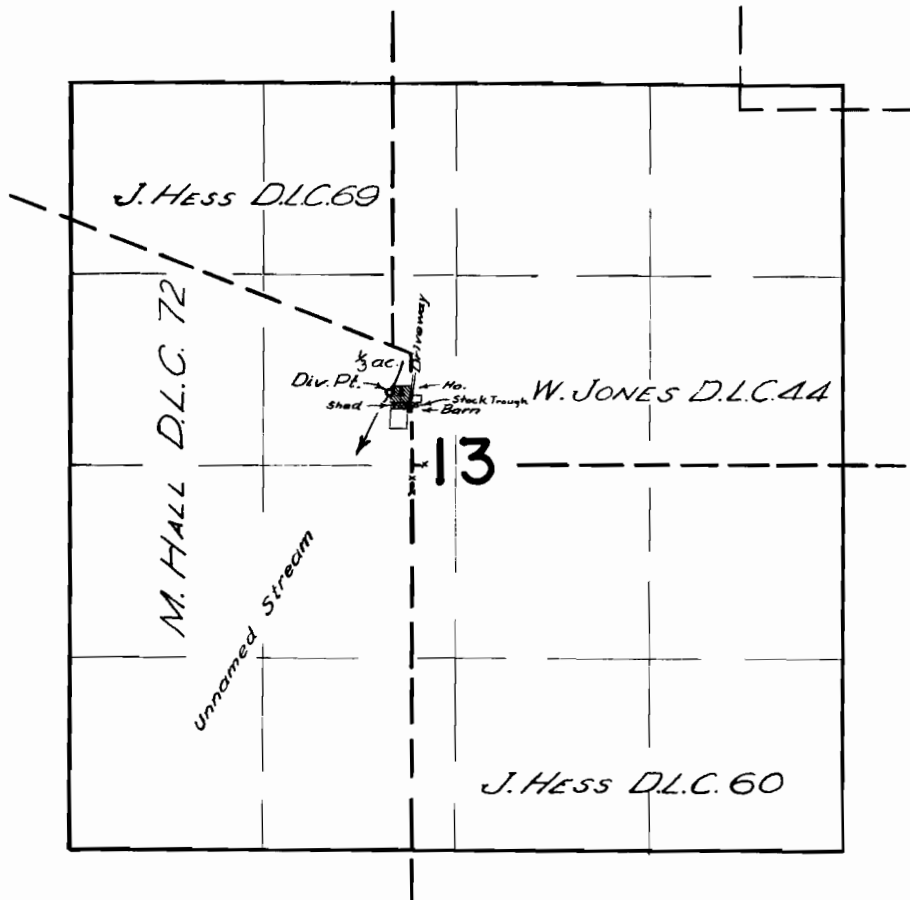

FINAL PROOF SURVEY UNDER

Application No. 37897 Permit No. 28239
IN NAME OF

ARTHUR H. WINTERS

Surveyed April 12 1963, by m. Bish