


# T. 5 S. R. 6 W. W. M.

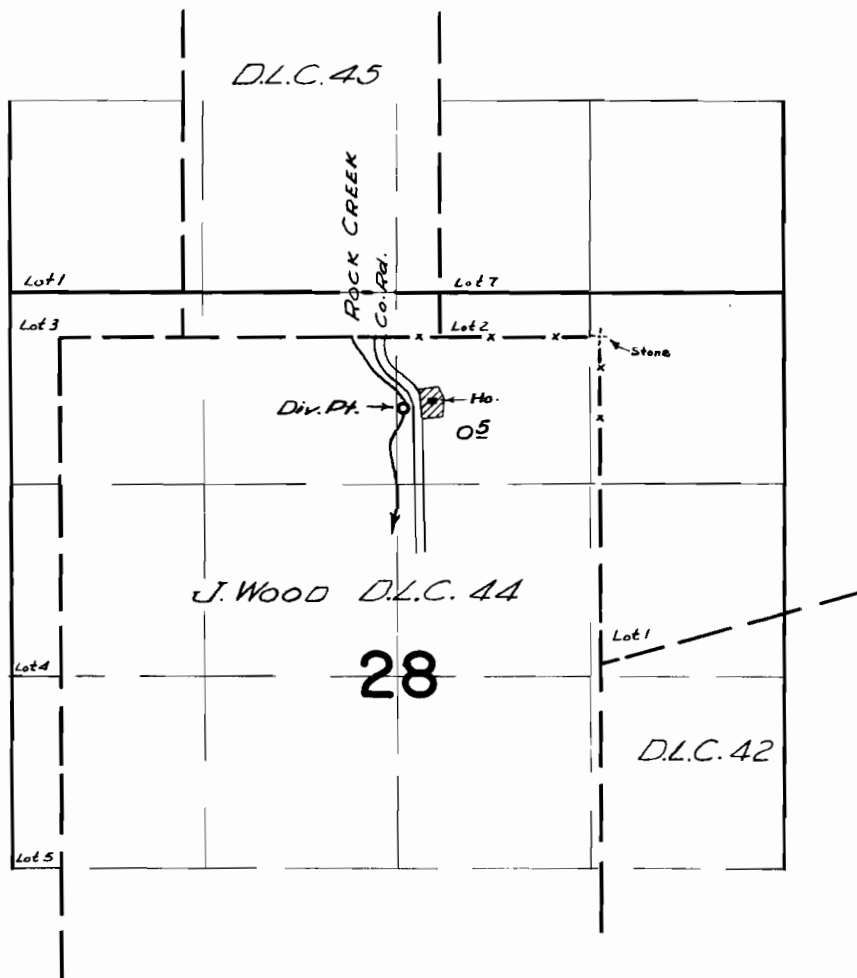

## FINAL PROOF SURVEY UNDER

Application No. 37901 Permit No. 28240  
IN NAME OF

WILLIAM OTIS PAYNE

Surveyed MAY 15 1963, by m. Bish