


T.2S.R.3E.W.M.

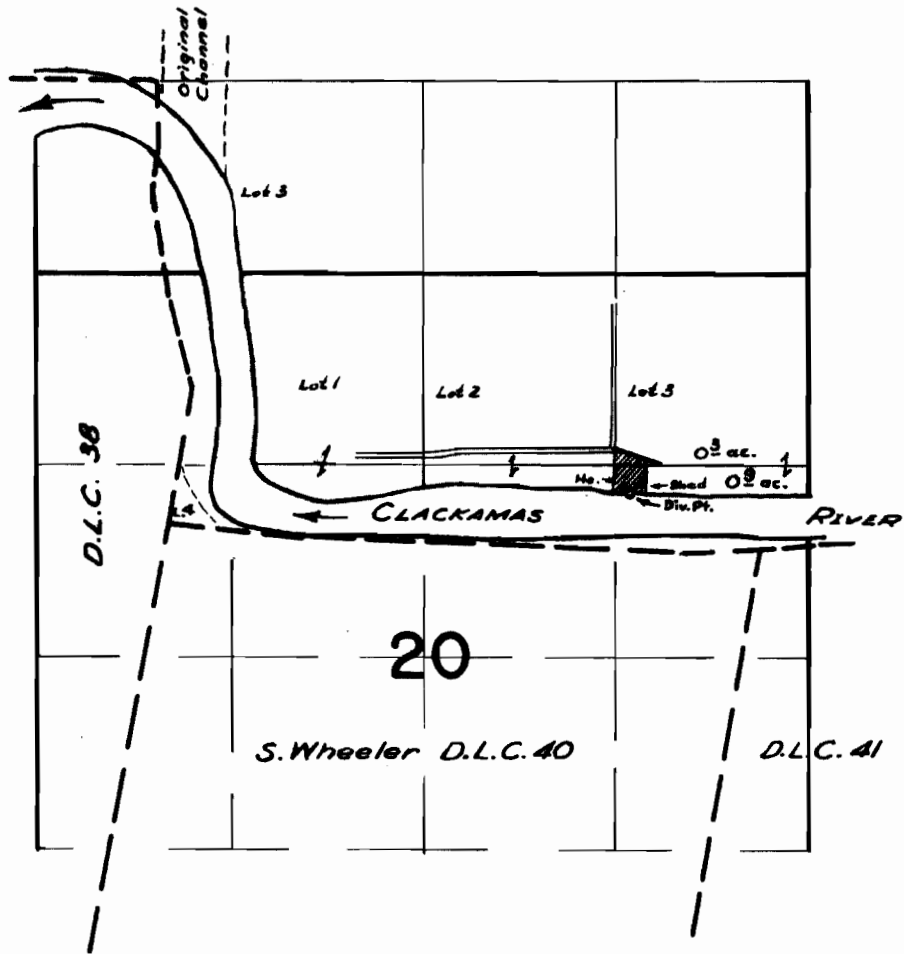

FINAL PROOF SURVEY
UNDER

Application No. 33314 Permit No. 26406
IN NAME OF

LEWIS B. & MARJORIE R. BELL

Surveyed April 4 1963, by M. Bell