


T. 3 S. R. 1 W. W. M.

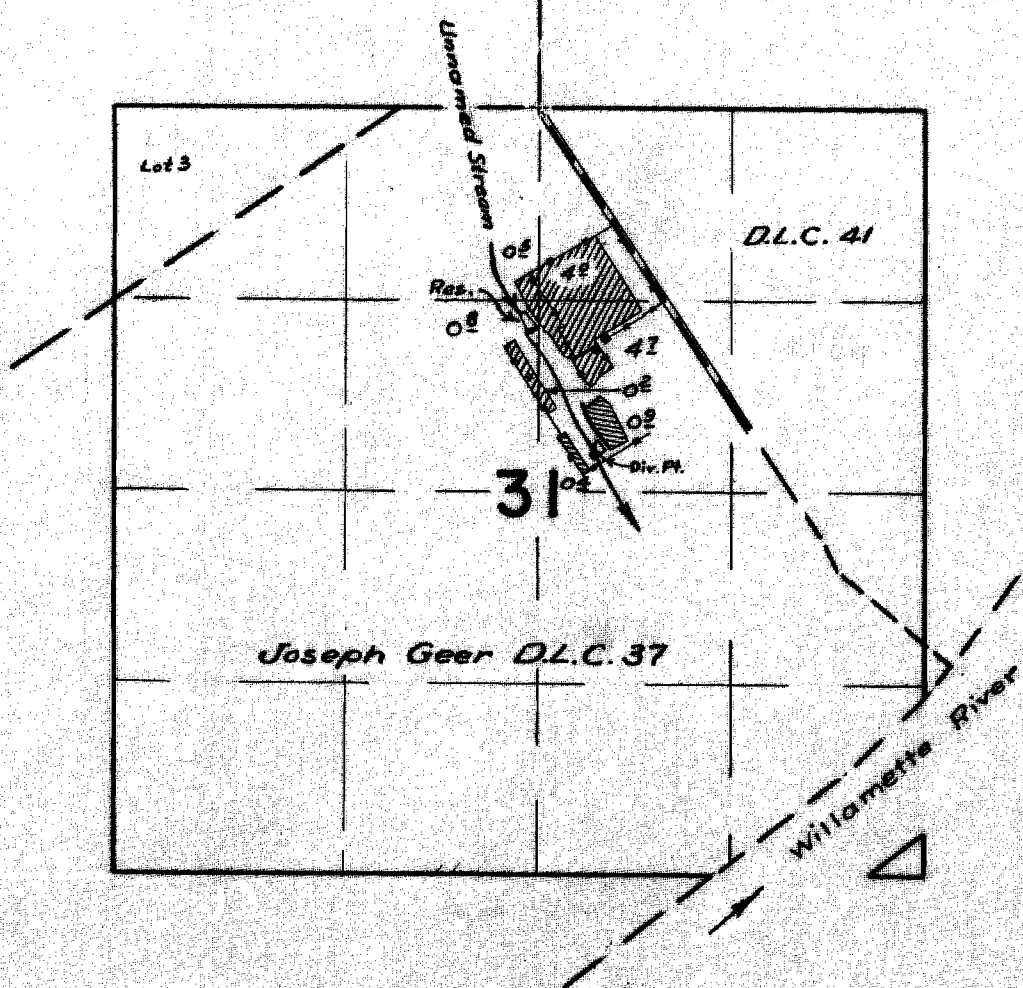

**FINAL PROOF SURVEY**  
UNDER

Application No. <sup>33427</sup> P-33426 Permit No. <sup>26451</sup> P-2298  
IN NAME OF

ROBERT E. GAINES

Surveyed APRIL 3, 1963, by M. Red