


T. 3 S. R. 1 W. W. M.

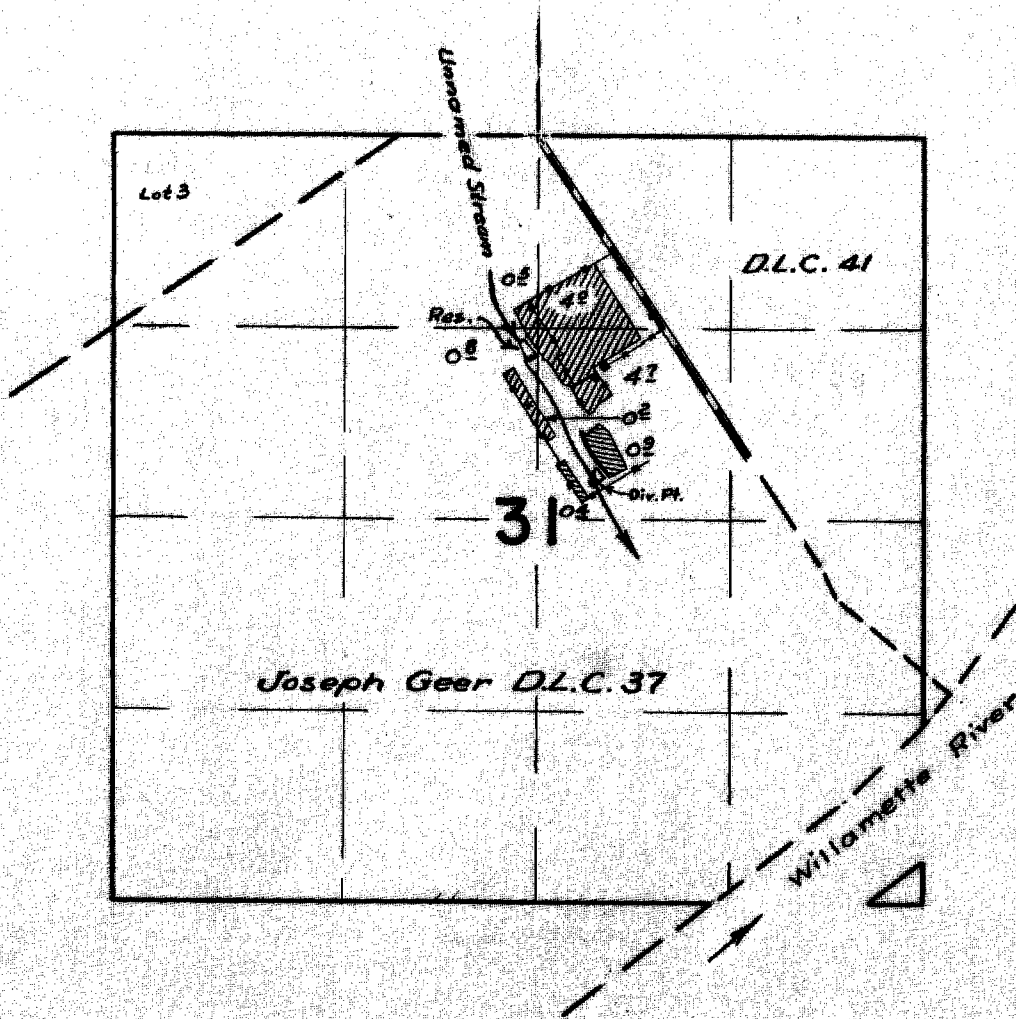

FINAL PROOF SURVEY
UNDER

Application No. 33427 P-33426 Permit No. 26431 P-2298
IN NAME OF

ROBERT E. GAINES

Surveyed APRIL 3 1963, by W. Red