


T. 2 S. R. 3 E. W. M.

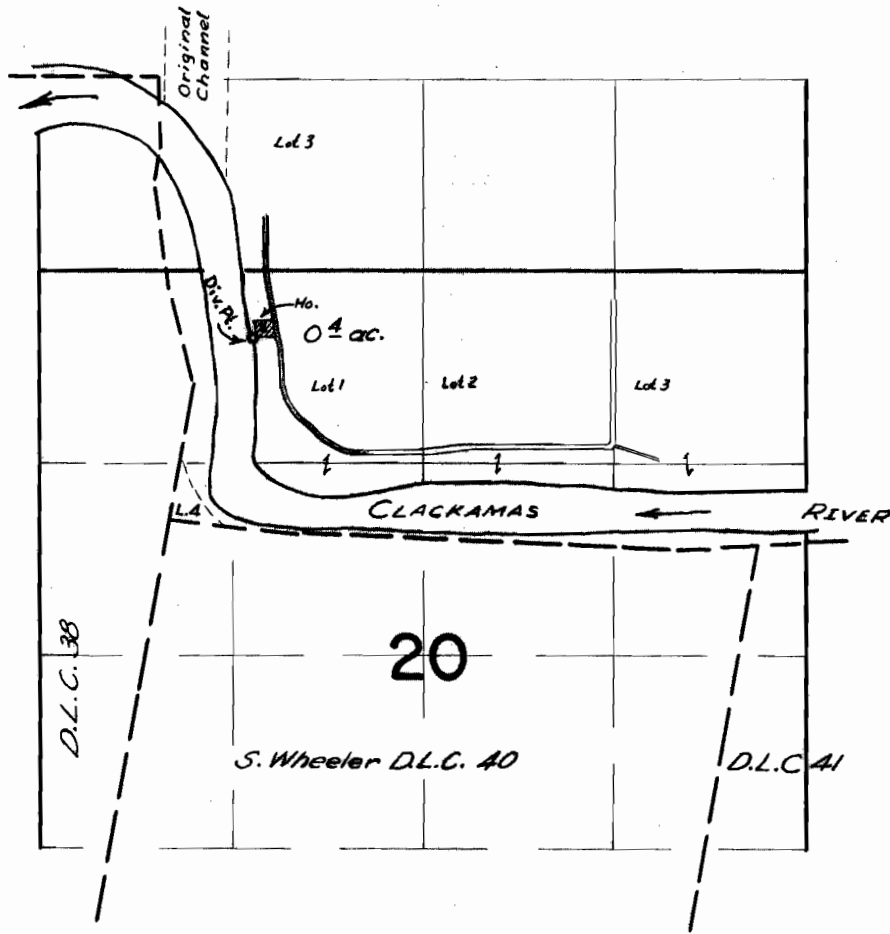

FINAL PROOF SURVEY
UNDER

Application No. 34103 Permit No. 26881
IN NAME OF

PAUL G. & D.M. RITZER

Surveyed April 4 1963, by m. Bish