


T. 3 S. R. 1 E. W. M.

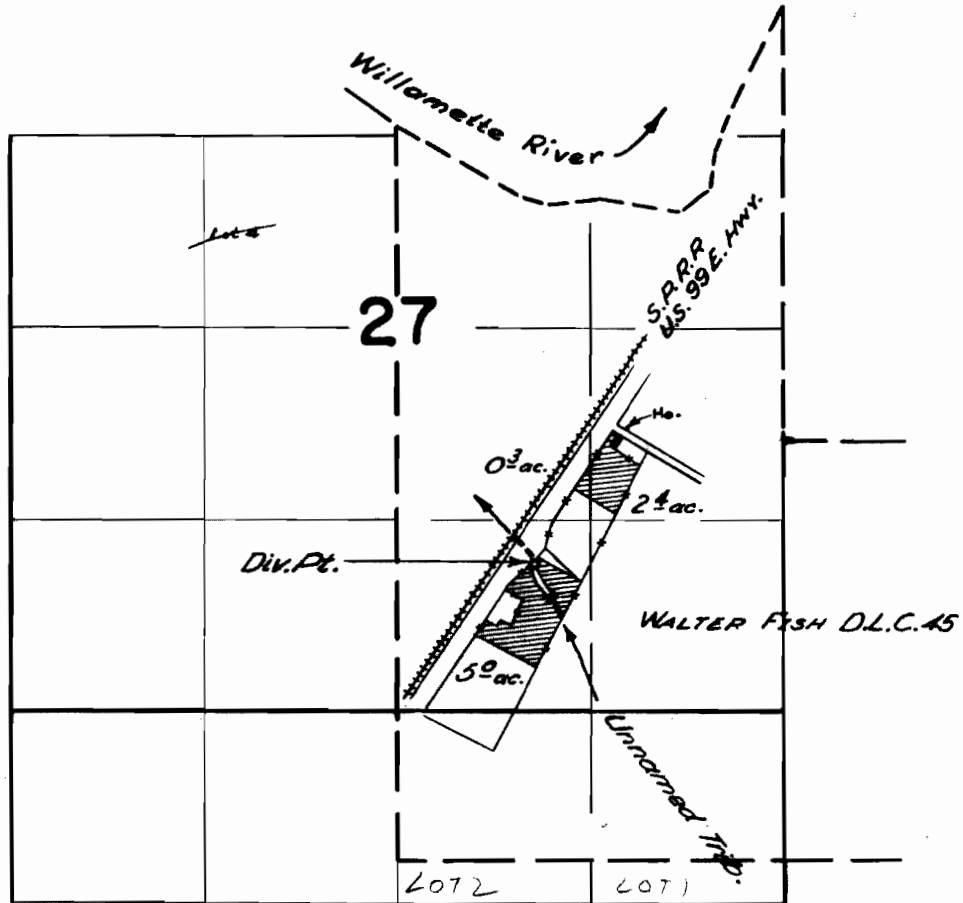

FINAL PROOF SURVEY UNDER

Application No. 34835 Permit No. 27349
IN NAME OF

LONNIE L. LOGSDON

Surveyed APRIL 5 1963, by M. Bish