


T.2S.R.1E.W.M.

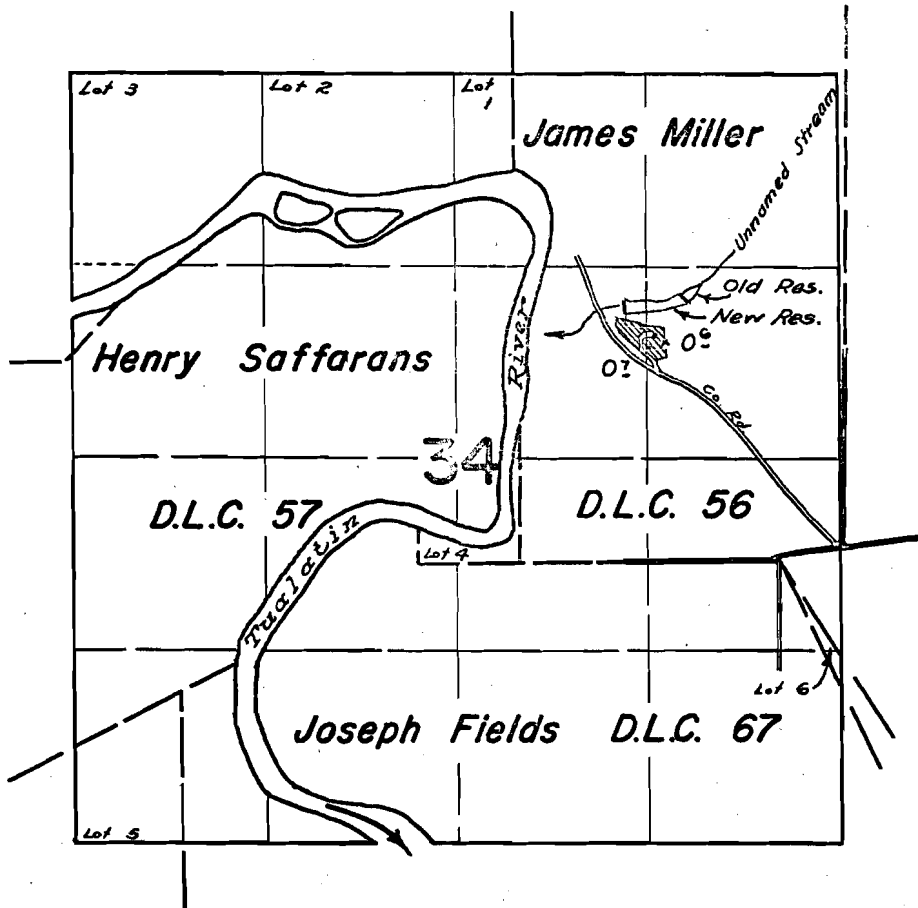

FINAL PROOF SURVEY
UNDER

R-31289 R-1995
Application No. 31290 Permit No. 24723
IN NAME OF

NATHAN O. WRIGHT

Surveyed May 3, 1963, by *L. Jackson*