


T.5S. R.2E. W.M.

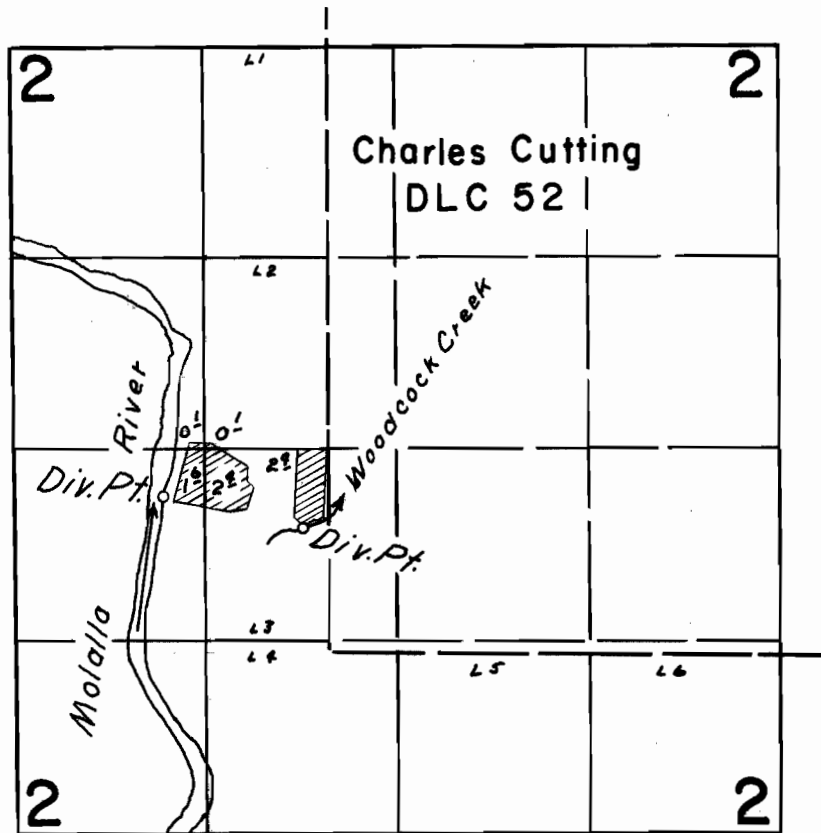

FINAL PROOF SURVEY
UNDER

Application No. 37882 Permit No. 28232
IN NAME OF

LEONARD C. TRAAEN

Surveyed July 1, 1964, by *C.J. Gardner*