


# T.17S.R.19 & 20E.W.M.

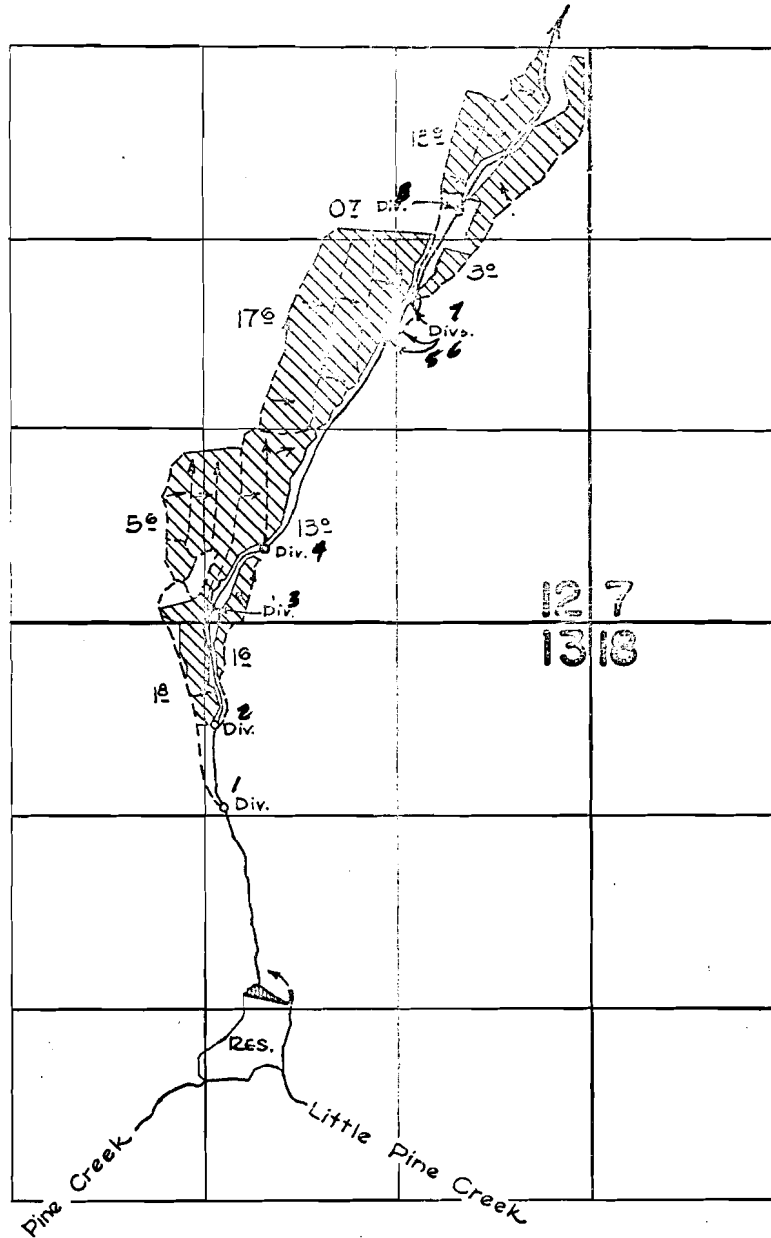

## FINAL PROOF SURVEY UNDER

R-24223                      R-1001  
 Application No. 24229    Permit No. 19151  
 IN NAME OF

N. L., PHILLIP & NORM. WEIGAND

Surveyed Oct. 24-25 1957, by C. O. BARTEL  
 July 11, 1963 by T. LAUER

*P#19151*