


# T.17S.R.19 & 20E.W.M.

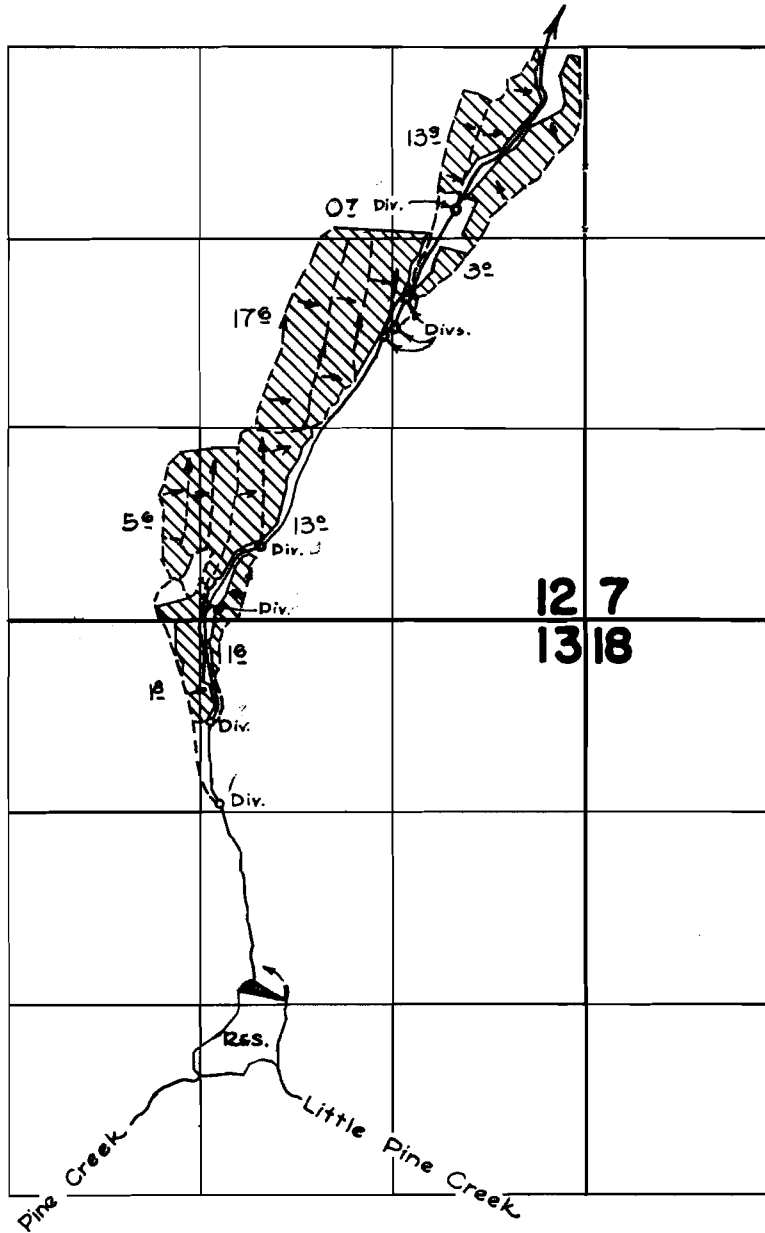

## FINAL PROOF SURVEY UNDER

Application No. 24229 Permit No. 19151  
 IN NAME OF

N. L., PHILLIP & NORM. WEIGAND

Surveyed Oct. 24-25 1957, by C. O. BARTHEL  
 July 11, 1963 by T. LAUER