


T.26S.R.5W.W.M.

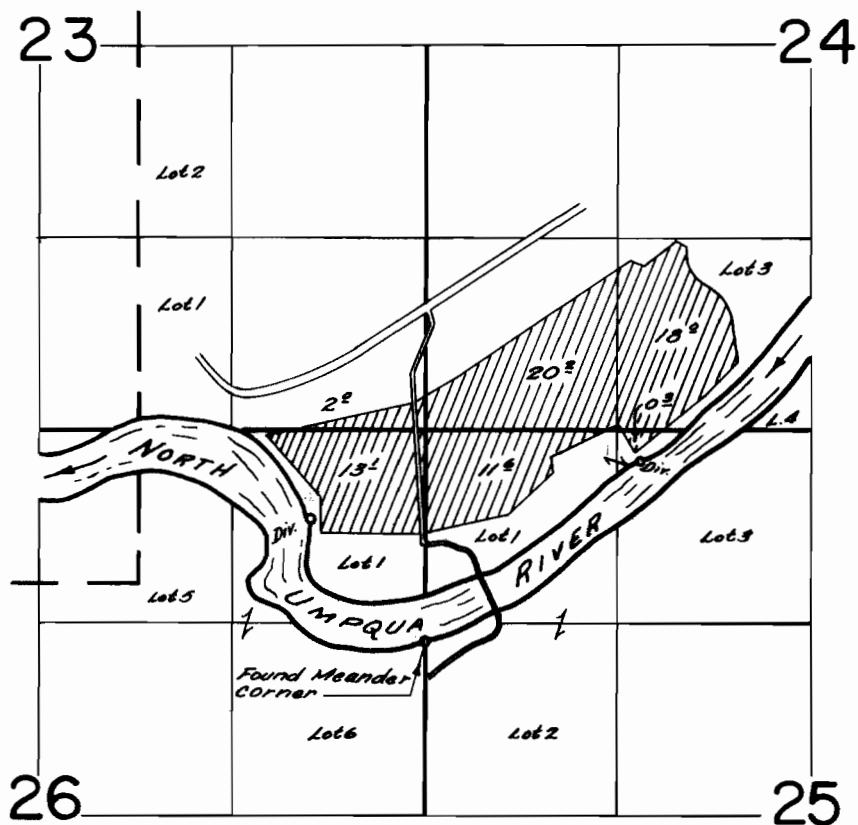

FINAL PROOF SURVEY
UNDER

Application No. 30760 Permit No. 24363
IN NAME OF

Edward Kohlhagen

Surveyed April 3 1963, by C. Q. Bartels