


T.30S. R.6W.W.M.

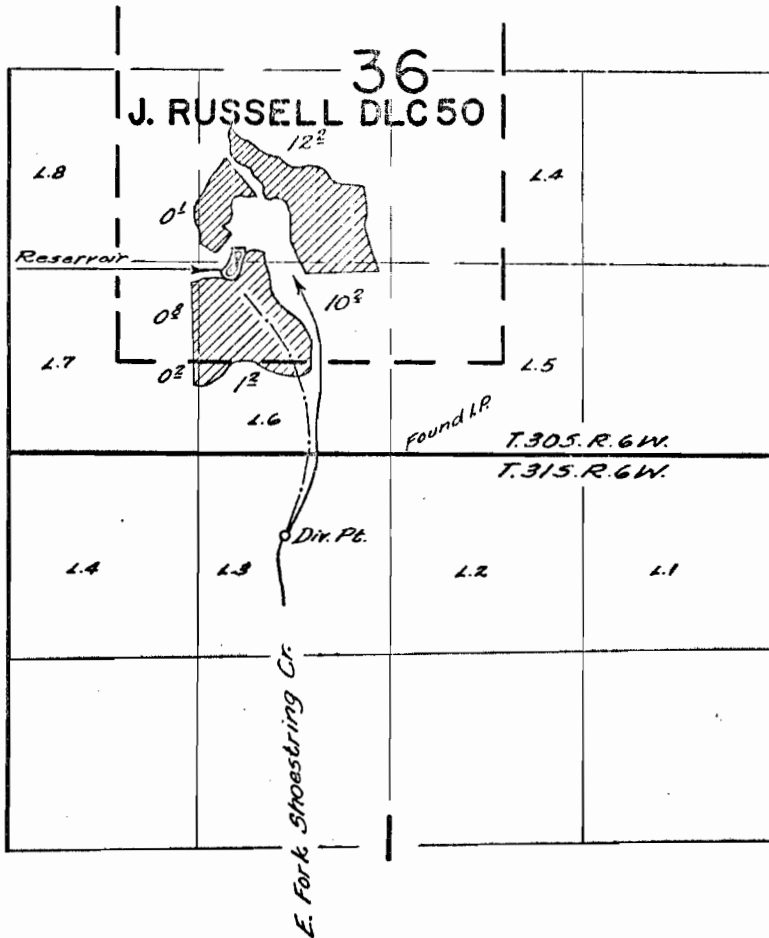

FINAL PROOF SURVEY
UNDER

R-31744 R-2099
Application No. 31866 Permit No. 25232
IN NAME OF

H. W. & Myrtle Hiles

Surveyed JUNE 11, 1963, by T. Lauer