


T.22S.R.4W.W.M.

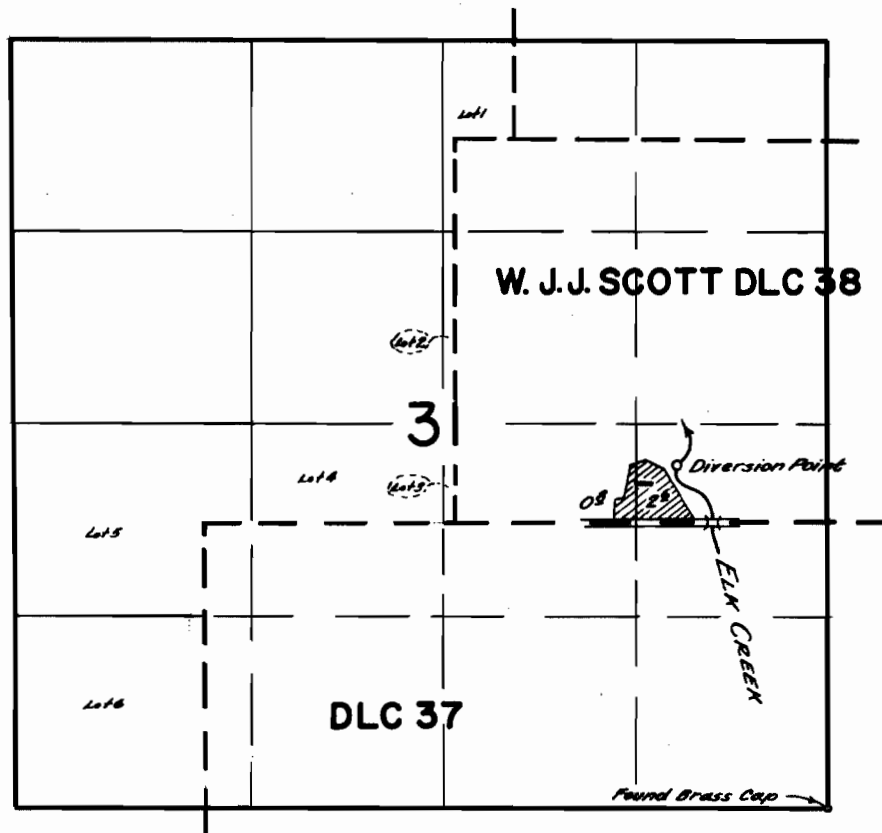

FINAL PROOF SURVEY
UNDER

Application No. 32013... Permit No. 25537...
IN NAME OF

.....**Fred H. Booth**.....

Surveyed June 4... 1963, by T. Lauer.....