


T.27S.R.6W.W.M.

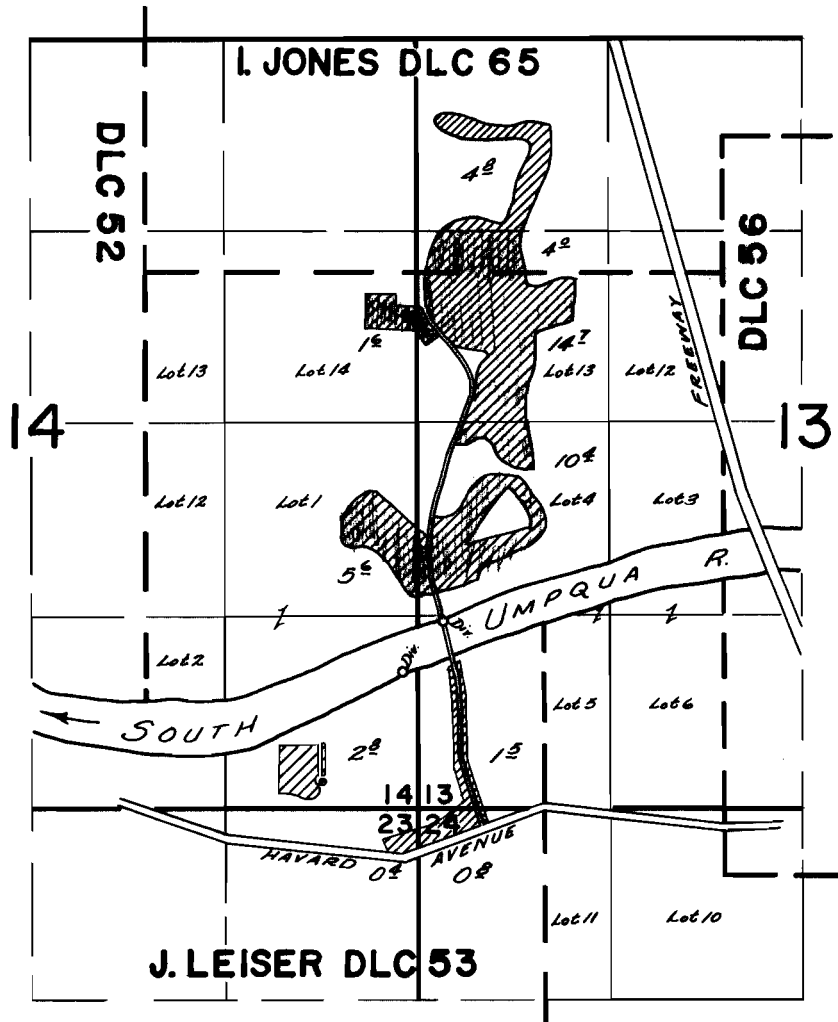

**FINAL PROOF SURVEY**  
UNDER

Application No. 32395 Permit No. 25580  
IN NAME OF

Veterans Administration Hosp.

Surveyed June 10, 1963, by T. Lauer