


T. 29S. R. 5W. W.M.

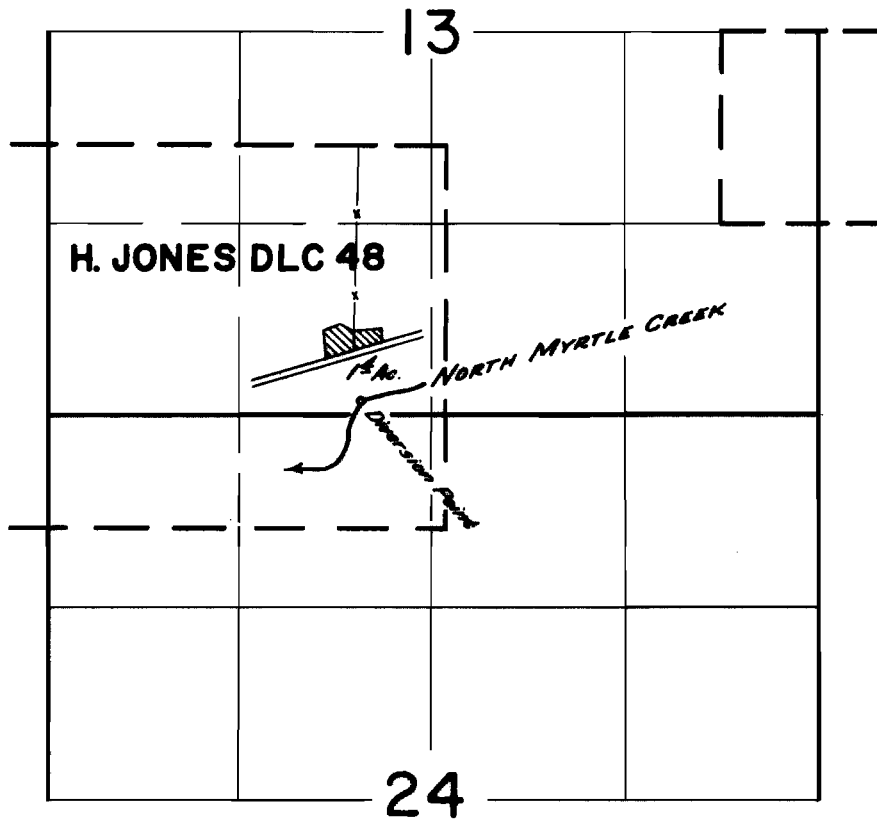

**FINAL PROOF SURVEY**  
UNDER

Application No. 34240... Permit No. 27000...  
IN NAME OF

..... **Ralph & Lena Maddux** .....

Surveyed May 16... 1963, by T. Lauer.....