


T.21S.R.5W.W.M.

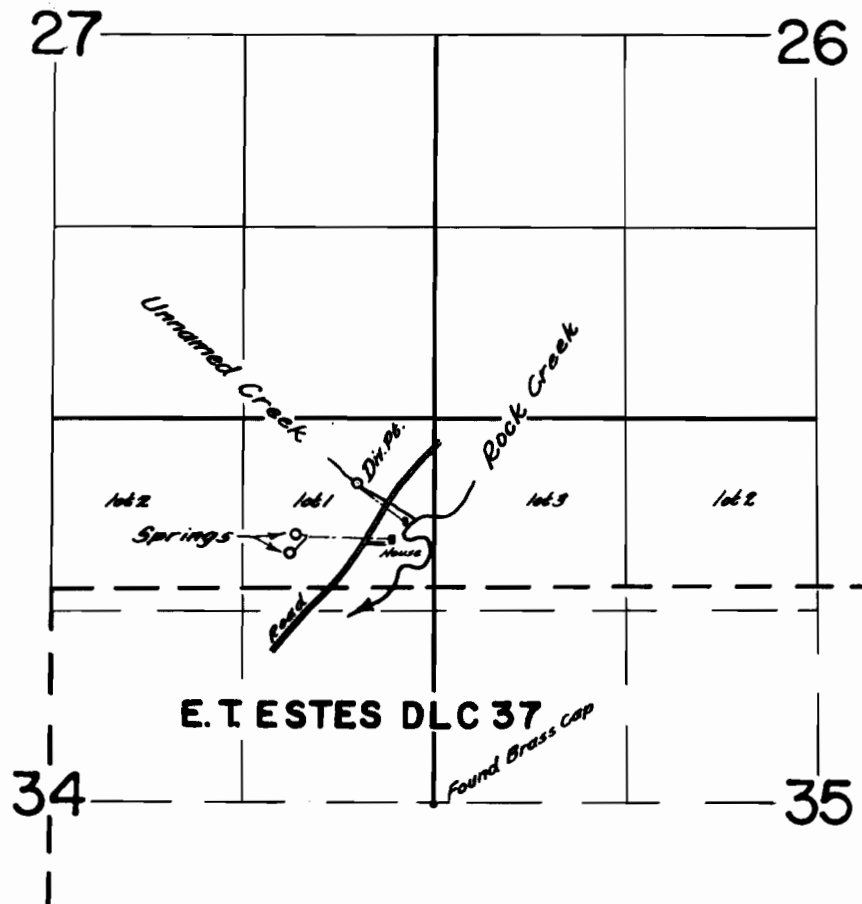

FINAL PROOF SURVEY
UNDER

Application No. 33900 Permit No. 27183
IN NAME OF

R. L. Bridges

Surveyed March 26 1963, by C.O. Bartels