


T.28S.R.6W.W.M.

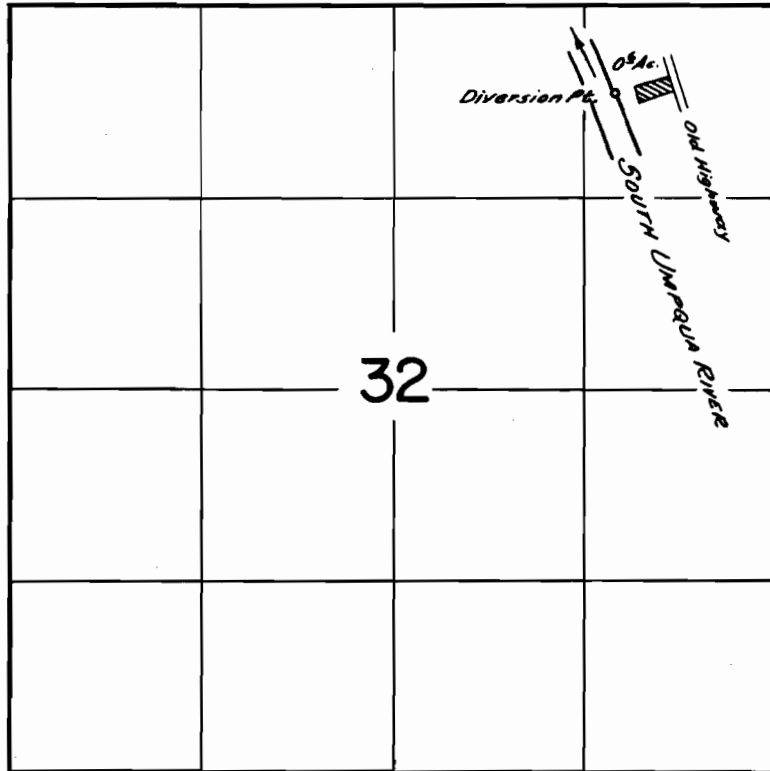

FINAL PROOF SURVEY
UNDER

Application No. 34653 Permit No. 27252
IN NAME OF

Francis John Wilkerson

Surveyed May 13 1963, by T. Lauer