


T.26S.R.2W.W.M.

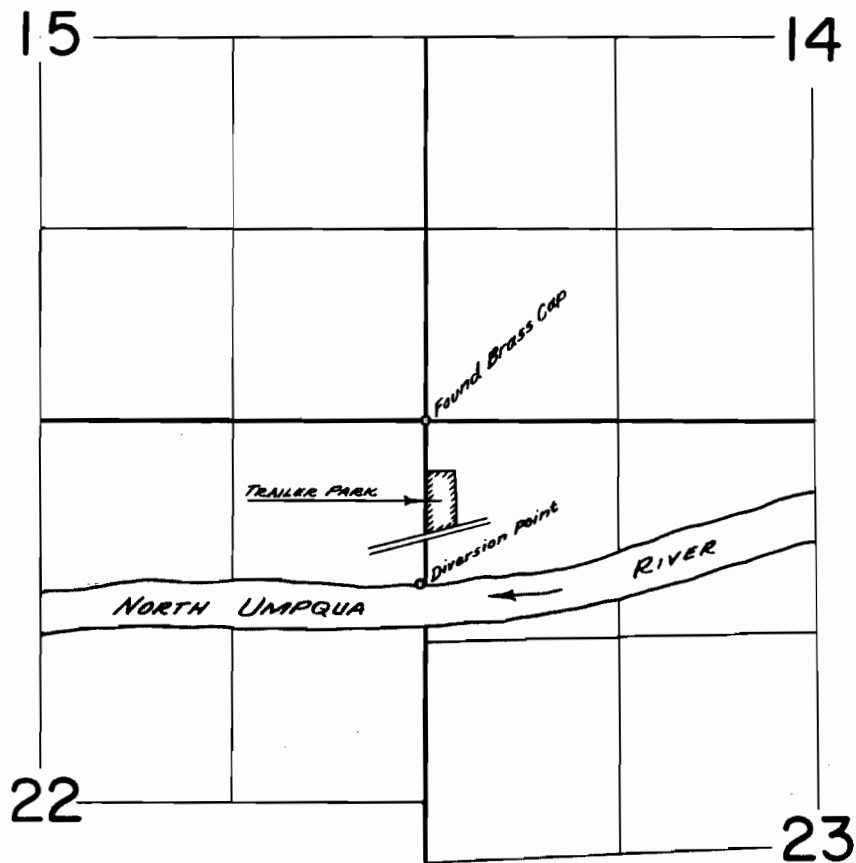

FINAL PROOF SURVEY
UNDER

Application No. 34793. Permit No. 27329.
IN NAME OF

.....**Max W. Lockwood**.....

Surveyed June 8, 1963, by I. Lauer.....