


T.23S.R.4W.W.M.

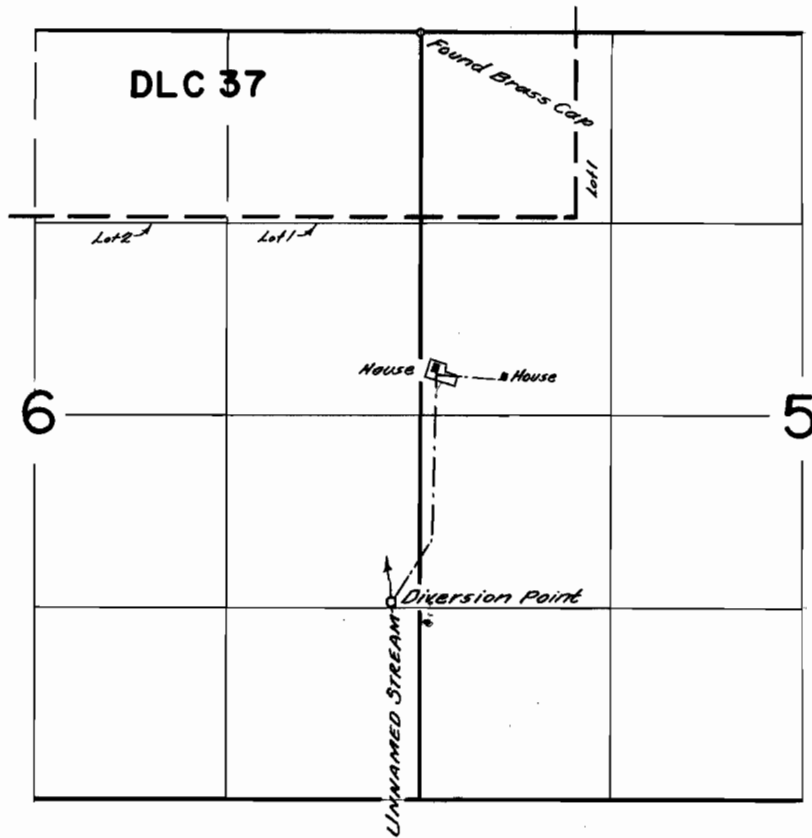

FINAL PROOF SURVEY

UNDER

Application No. 3.7505 Permit No. 27952
IN NAME OF _____

.....Frederick Grant & Jane Ruth Applegate

Surveyed June 4 1963, by T. Lauer.....