


T.28S.R.6W.W.M.

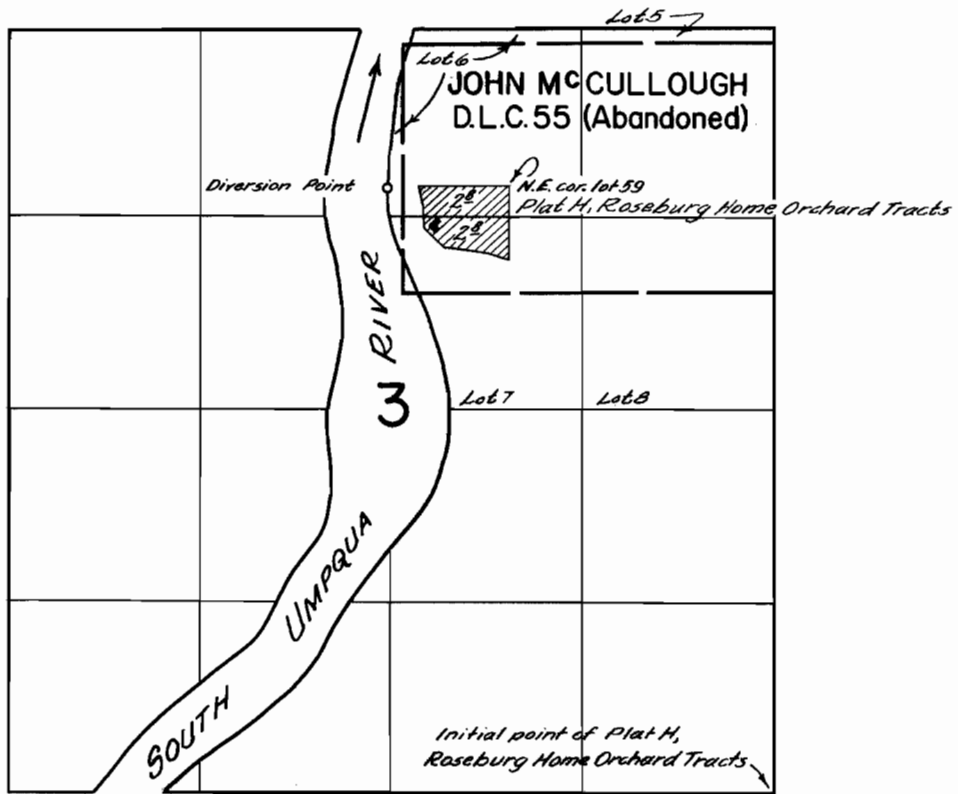

FINAL PROOF SURVEY
UNDER

Application No. 37656 Permit No. 28071
IN NAME OF

Milo L. Laharty

Surveyed May 14 1963, by T. Lauer