


T.27 & 28S.R.7W.W.M.

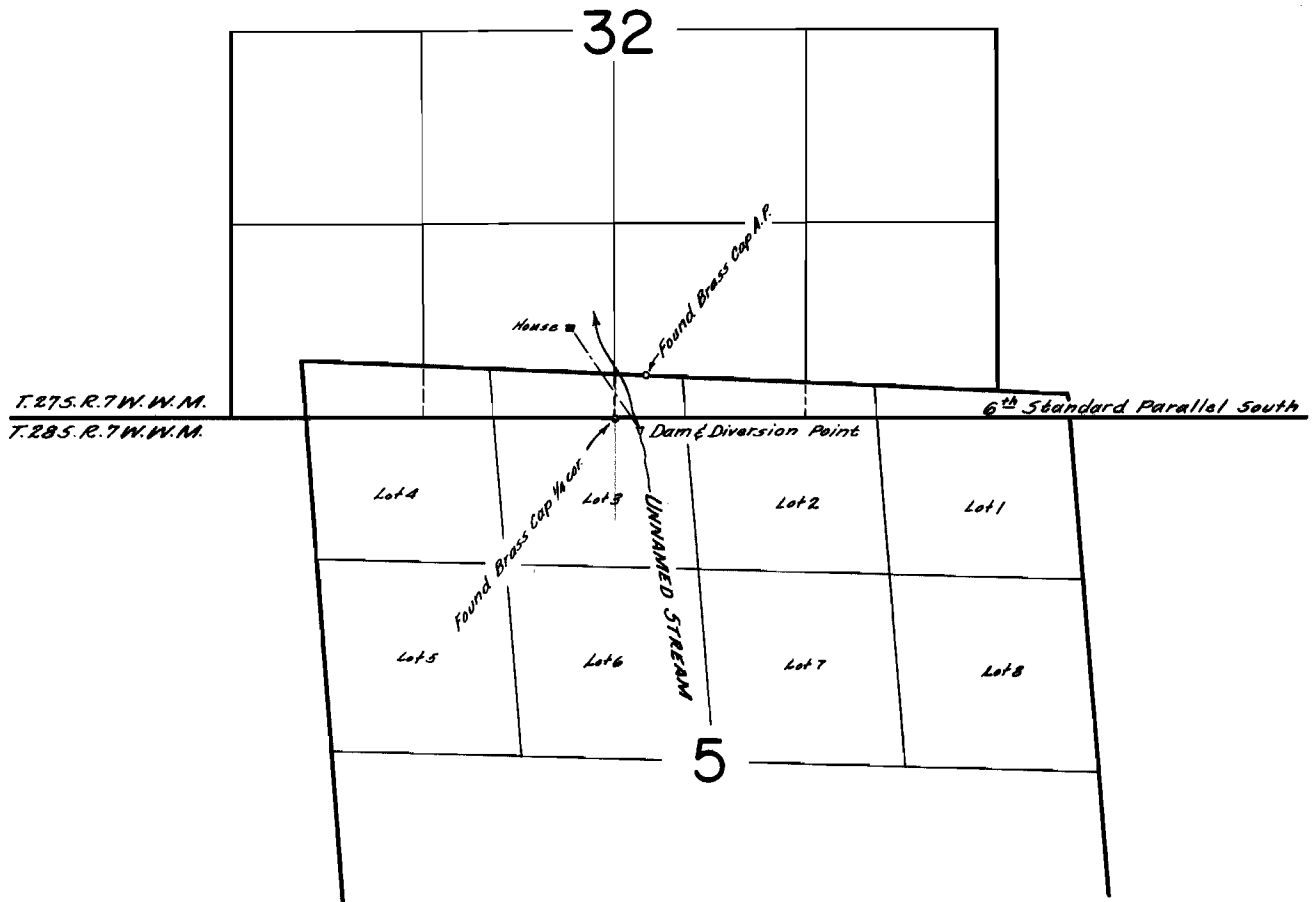

FINAL PROOF SURVEY
UNDER

Application No. R-37947 Permit No. R-3140
37948 28302
IN NAME OF

Melvin Colwell

Surveyed May 15 1963, by T. Lauer