


T.27&28S.R.7W.W.M.

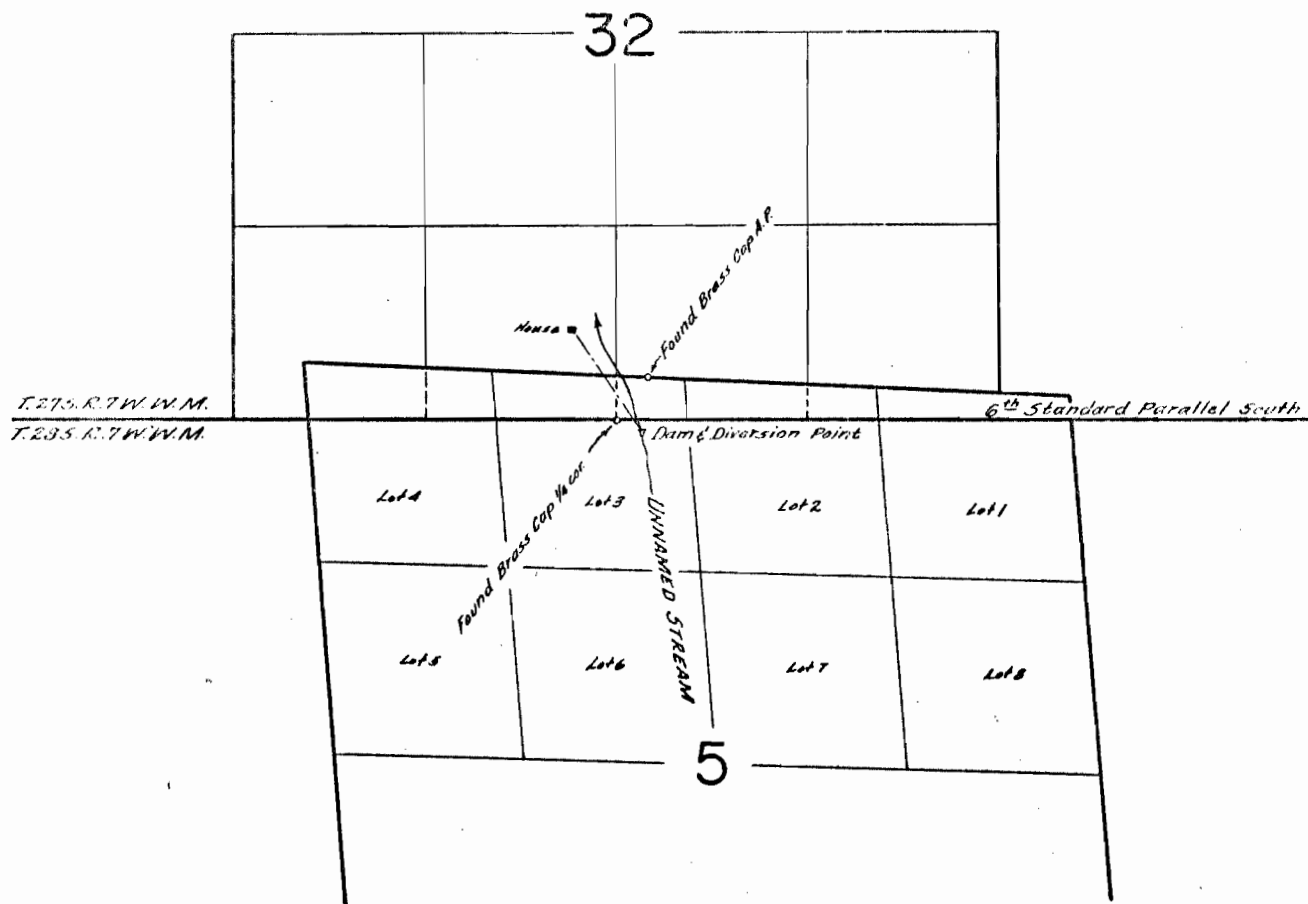

FINAL PROOF SURVEY
UNDER

Application No. R-37947 37948 Permit No. R-3140 28302
IN NAME OF

Melvin Colwell

Surveyed May 15, 1963, by T. Louer