


T.27S.R.6W.W.M.

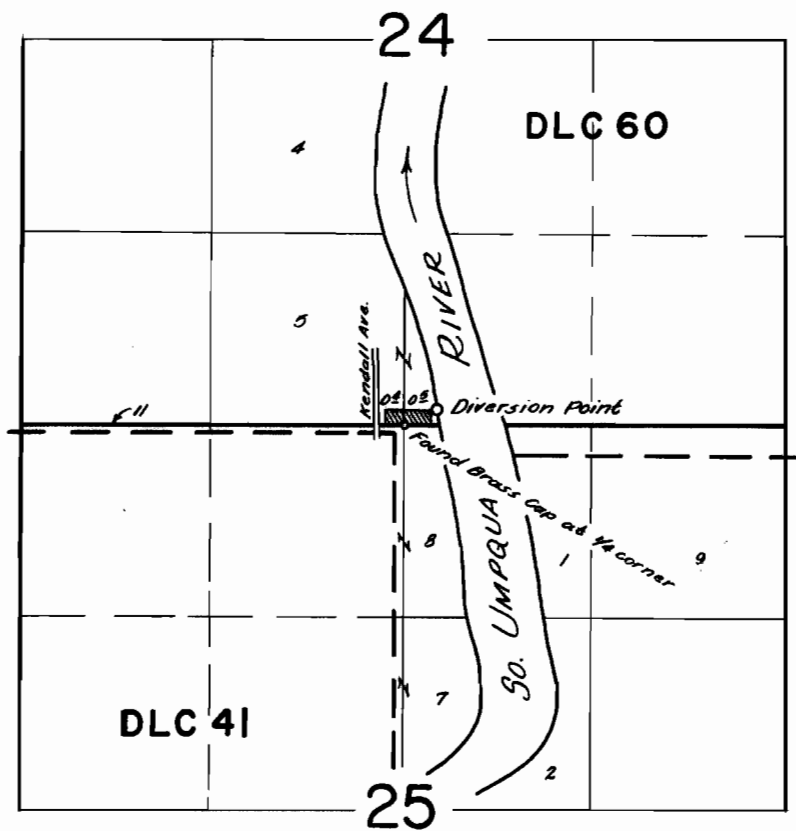

**FINAL PROOF SURVEY**  
UNDER

Application No. 38115 Permit No. 28500  
IN NAME OF

Earl R. Siples

Surveyed May 15 1963, by T. Lauer