


T.26S.R.7W.W.M.

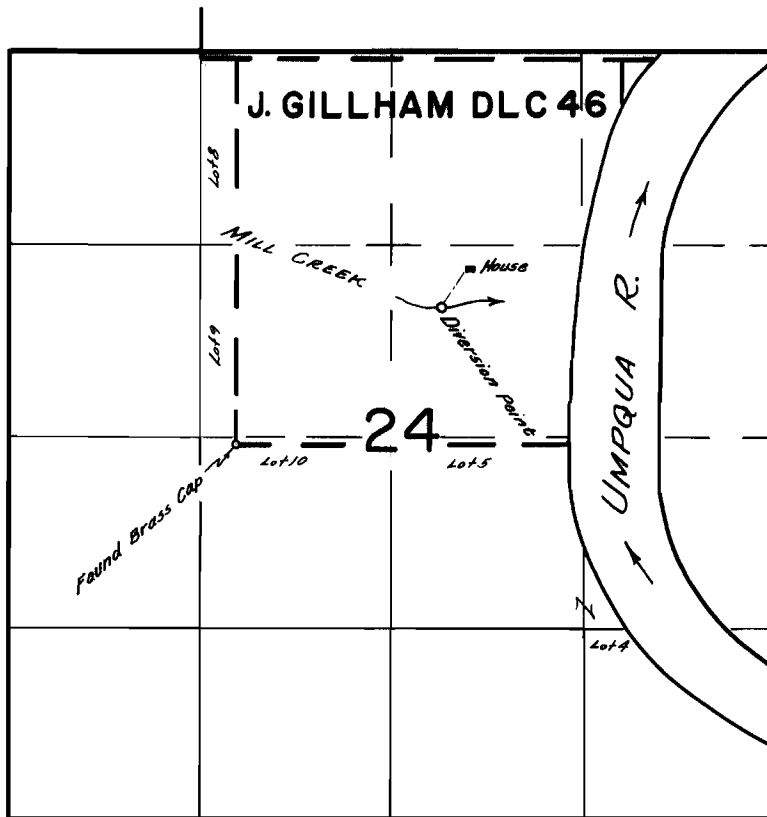

FINAL PROOF SURVEY
UNDER

Application No. 38340 Permit No. 28538
IN NAME OF

E. R. & Jane Lutman

Surveyed May 17 1963, by T. Lauer