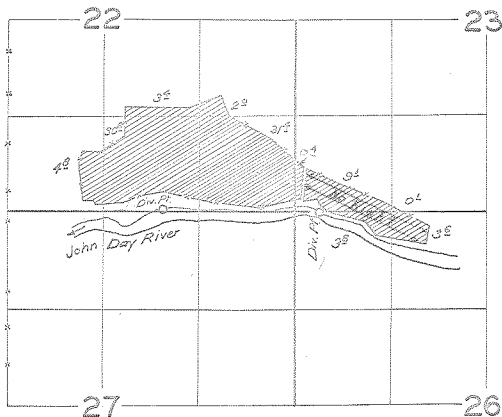


T.13S. R.29E.W.M.

FINAL PROOF SURVEY  
UNDERApplication No. 34754... Permit No. 27283.  
IN NAME OF

ESTATE OF JOHN CAWSE.....

Surveyed Nov. 15, 1962, by Ralph Jackson

*Carl Lee Martin*